


# T5S. R3E. WM.

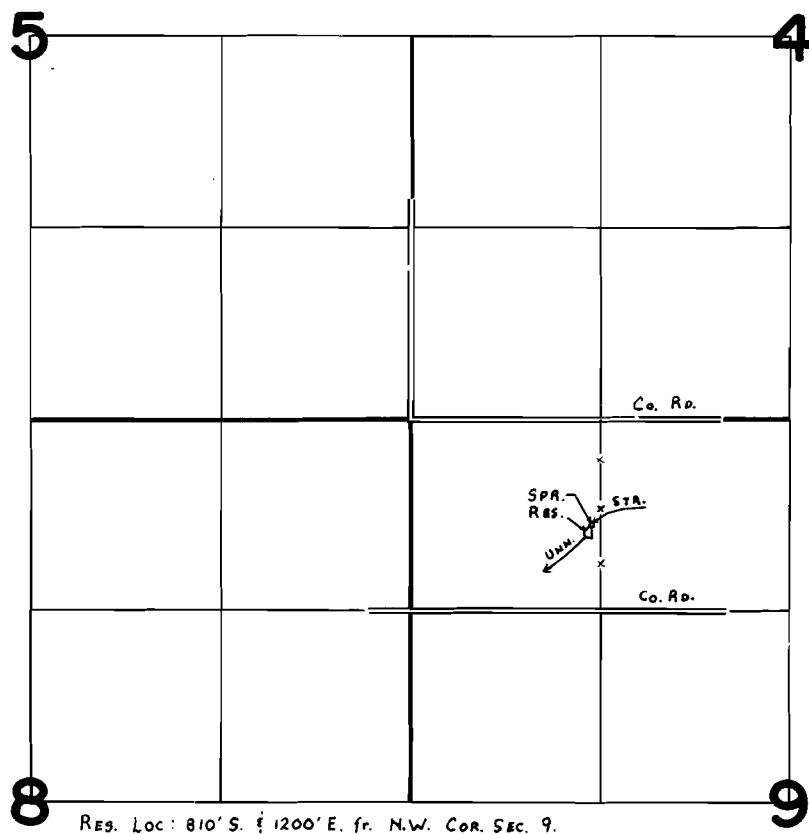

## FINAL PROOF SURVEY UNDER

49855 37491  
Application No. R-49876 Permit No. R-6087.  
IN NAME OF

**WILLIAM C. OLNEY & MARY L. J. WHEELER**

Surveyed SEPT. 25 1978, by C. L. HUGHES.