


# T2S. R7E. WM.

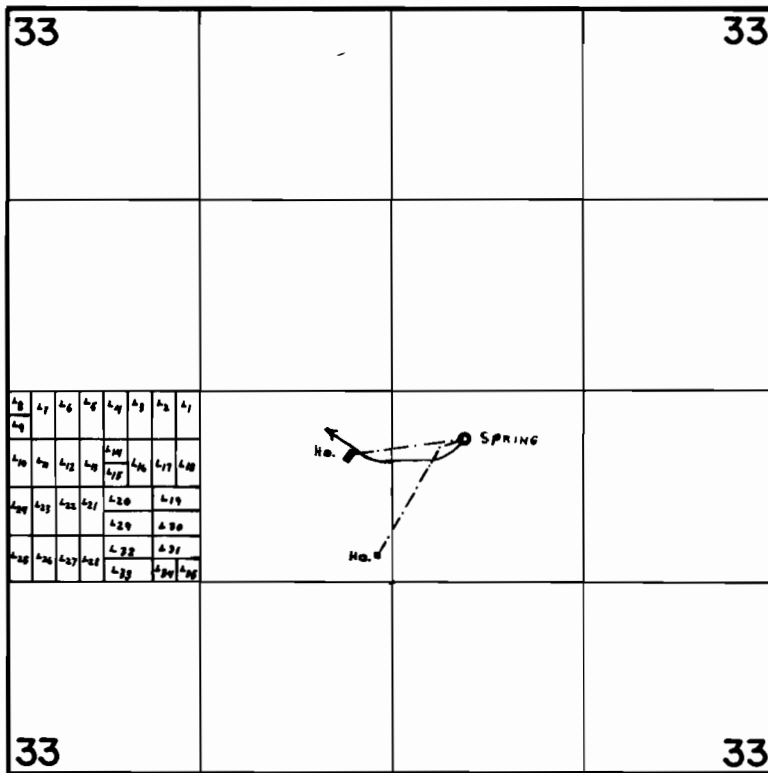

SPR. Loc : 330'S.  $\frac{1}{2}$  500'E. fr. C.  $\frac{1}{4}$  Cor. Sec. 33.

## FINAL PROOF SURVEY UNDER

Application No. 53934 Permit No. 40237  
IN NAME OF

HOWELL W. GESTER

Surveyed JULY 12, 1978, by C. L. HUGHES