


T2S. R2E. WM.

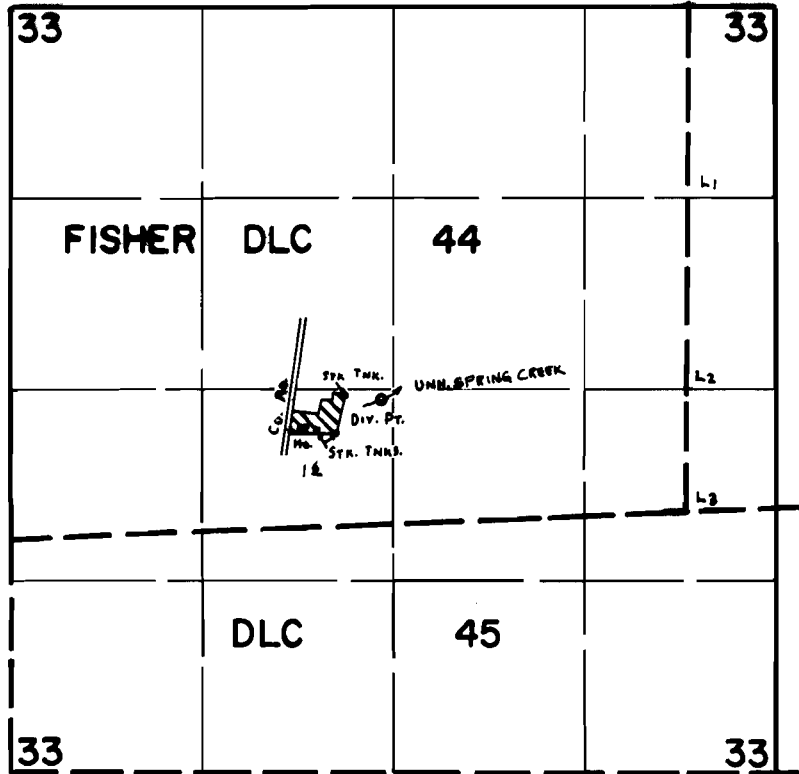

Div. Pt. Loc: 760' N. & 2080' W. fr SE. COR. FISHER DLC 44.

**FINAL PROOF SURVEY
UNDER**

Application No. 56628 Permit No. 42004
IN NAME OF

CLINTON J. & MAY CODY

Surveyed SEP. 28 1978 by C.L. HUGHES