


T2S. R2E. WM.

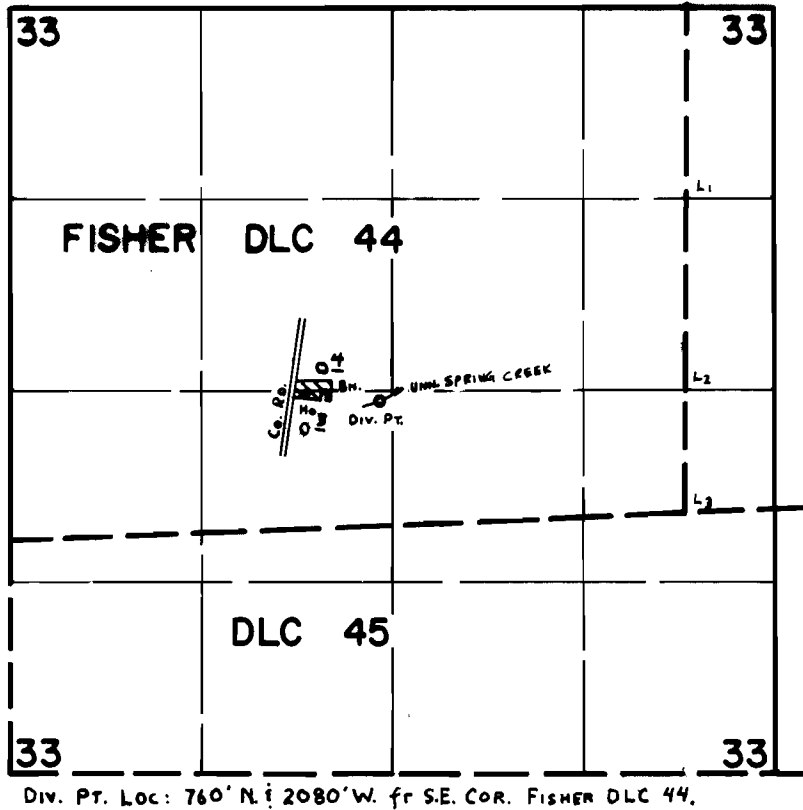

FINAL PROOF SURVEY
UNDER

Application No. 56629 Permit No. 42005
IN NAME OF

DONALD RAY & BILLIE F. JOHNSON

Surveyed SEP. 28 1978, by C. L. HUGHES