


T3S. RIW. WM.

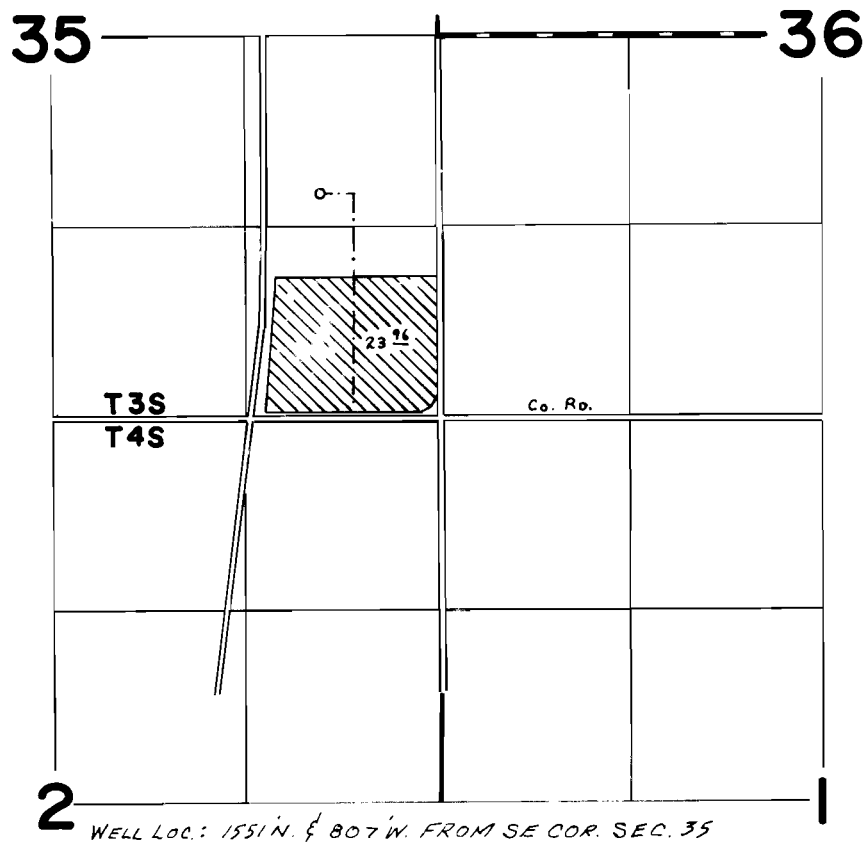

FINAL PROOF SURVEY UNDER

Application No. G-6086 Permit No. G-5771
IN NAME OF

CROWN ZELLERBACH CORP.

Surveyed AUG. 18, 1978, by C. L. HUGHES