


# T5S. R2E. WM.

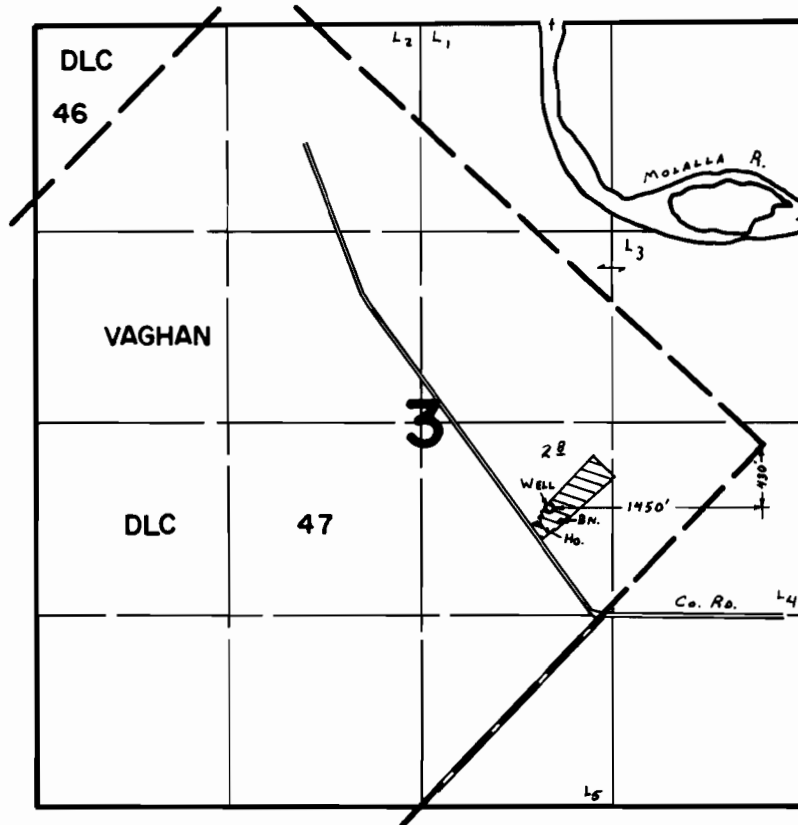

## FINAL PROOF SURVEY UNDER

Application No. G-8494. Permit No. G-7794.  
IN NAME OF

*William R. & Dawn M. Margari*

Surveyed SEPT. 25, 1978, by C. L. HUGHES