


T.28S. R.14W. W.M.

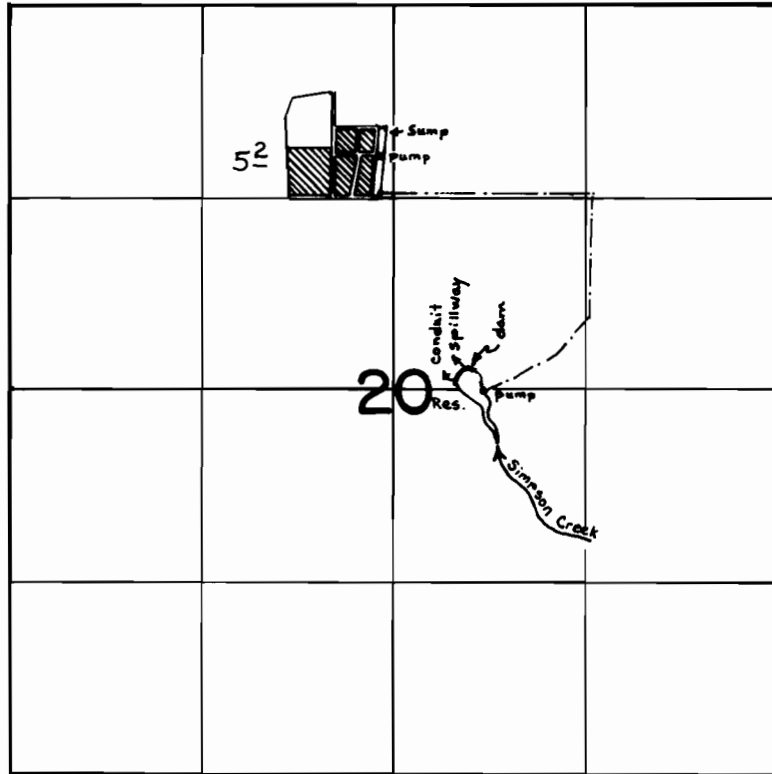

Dam Located: 100' N $\frac{1}{4}$ 450' E from C $\frac{1}{4}$ cor. Sec. 20

SCALE: 4" = 1 mile

FINAL PROOF SURVEY
UNDER

R-51625 R-6050

Application No. 51626 Permit No. 37294
IN NAME OF

INGRAM BROTHERS

Surveyed June 13, 1979, by S. Donaldson...