


T.28S. R.14W. W.M.

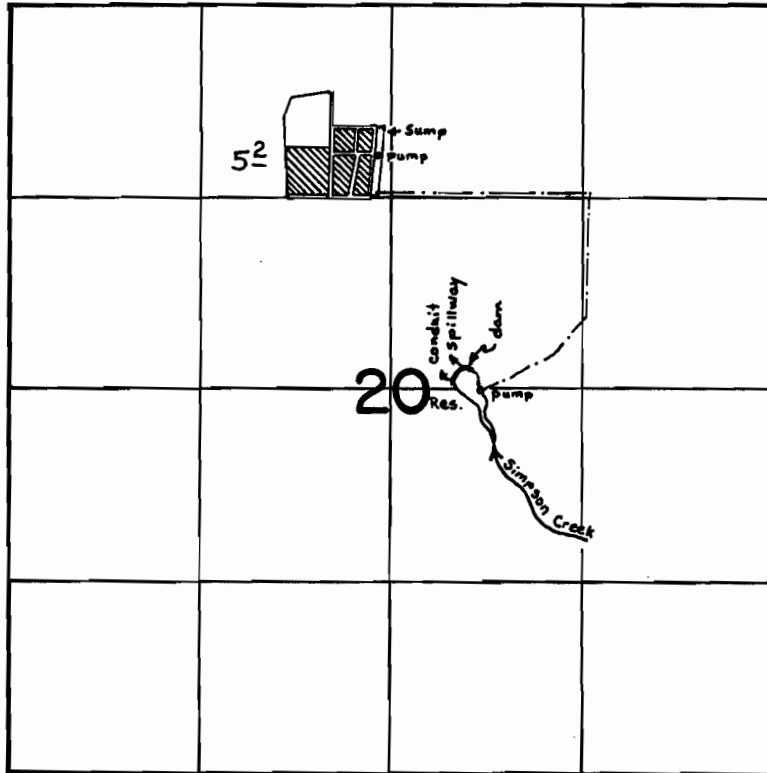

Dam Located: 100' N $\frac{1}{2}$ 450' E from C $\frac{1}{4}$ Cor. Sec. 20

SCALE: 4" = 1 mile

FINAL PROOF SURVEY
UNDER

R-51625 R-6050
Application No. 51626. Permit No. 37294...
IN NAME OF

..... **INGRAM BROTHERS**

Surveyed June 13, 1979, by S. Donaldson...