


# T.24S.,R.11W.,W.M.

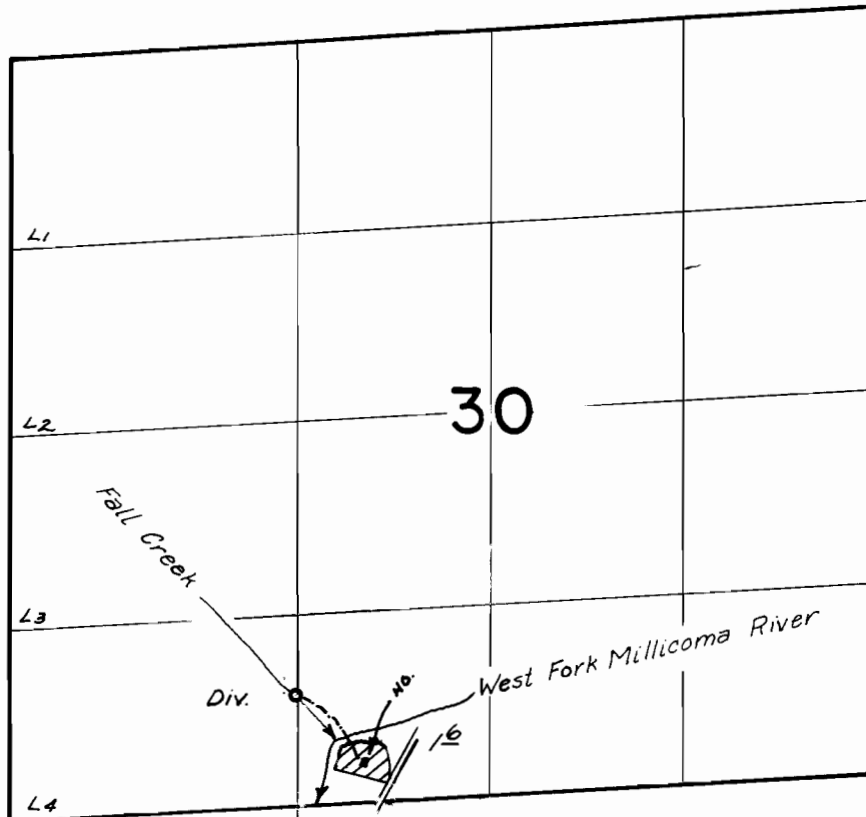

DIV. PT. LOC.: 680 #. N. & 1340 # W. from S. 1/4 Cor. Sec. 30

## FINAL PROOF SURVEY UNDER

Application No. 51092 Permit No. 38549  
IN NAME OF

Marie Walker

Surveyed July 27, 1977, by D. Norby