


T.23S. R.4W. W.M.

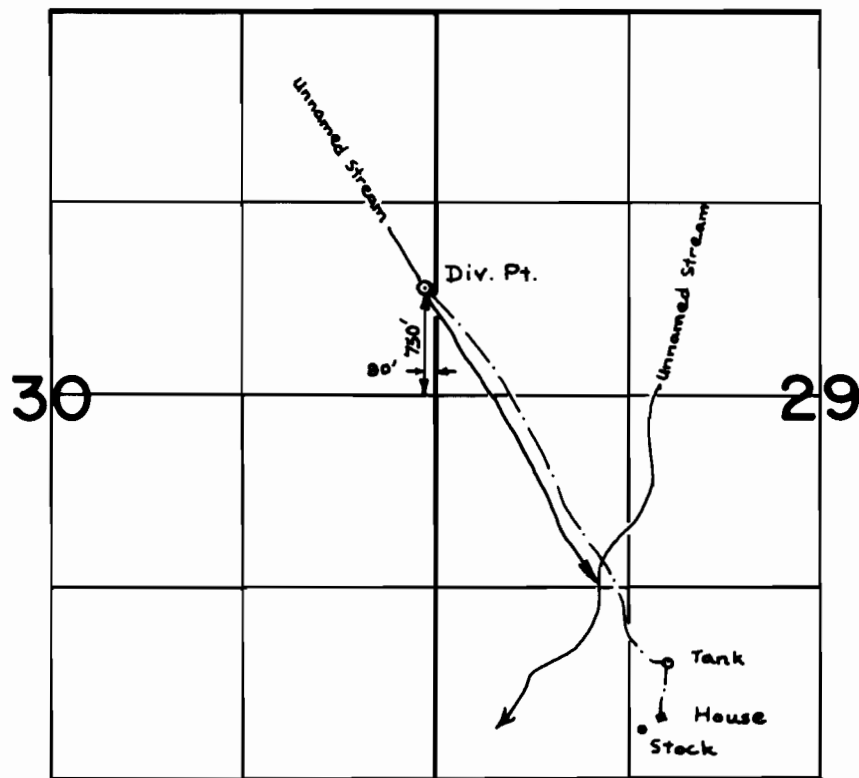

SCALE: 4" = 1 mile

FINAL PROOF SURVEY
UNDER

Application No. 51226 Permit No. 38699....
IN NAME OF

.....*Jack A. J. Jo E. Good*.....

Surveyed Oct. 3, 1979., by S. Donaldson..