


T.29S. R.8¹9W. W.M.

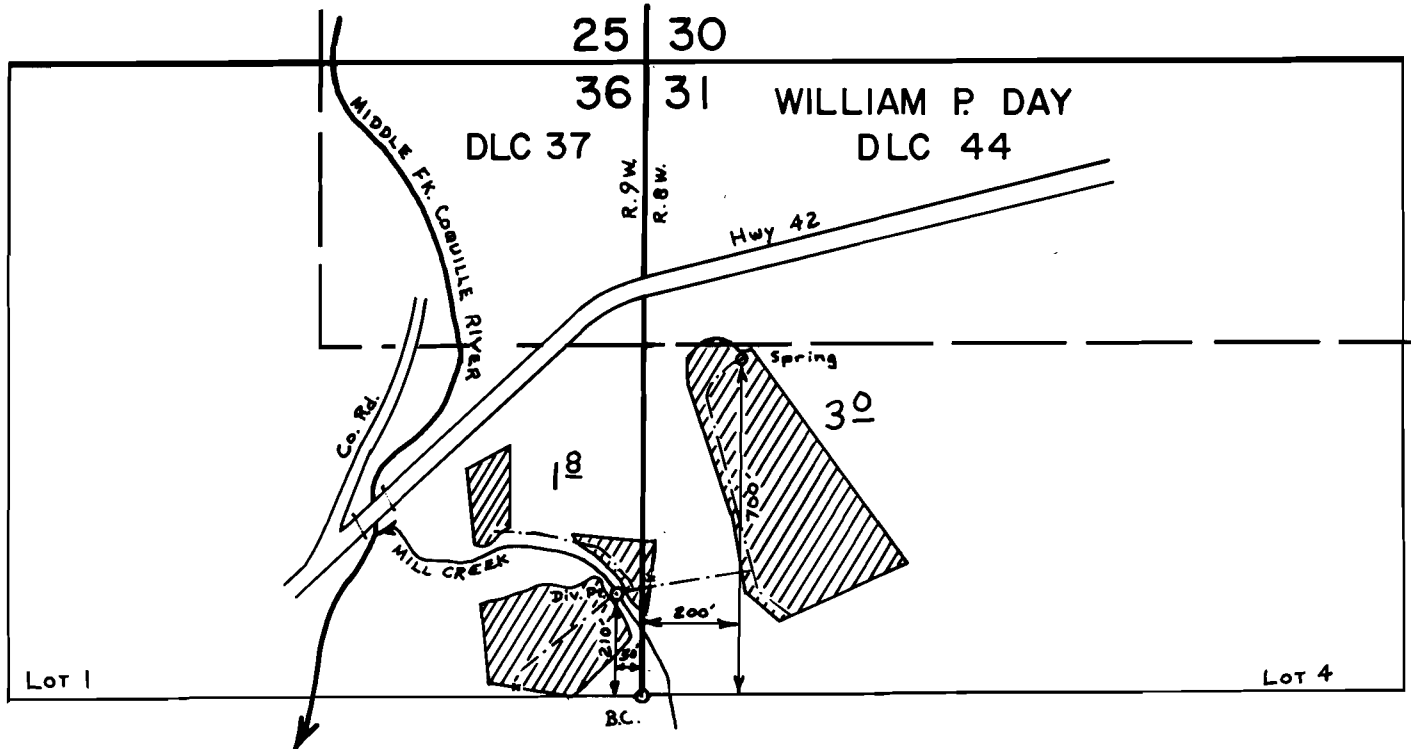

SCALE: 1" = 400'

FINAL PROOF SURVEY
UNDER

Application No. 54513 Permit No. 40884
IN NAME OF

CHARLES W. & EDNA M. GLADE

Surveyed July 13, 1978, by D. Sparks