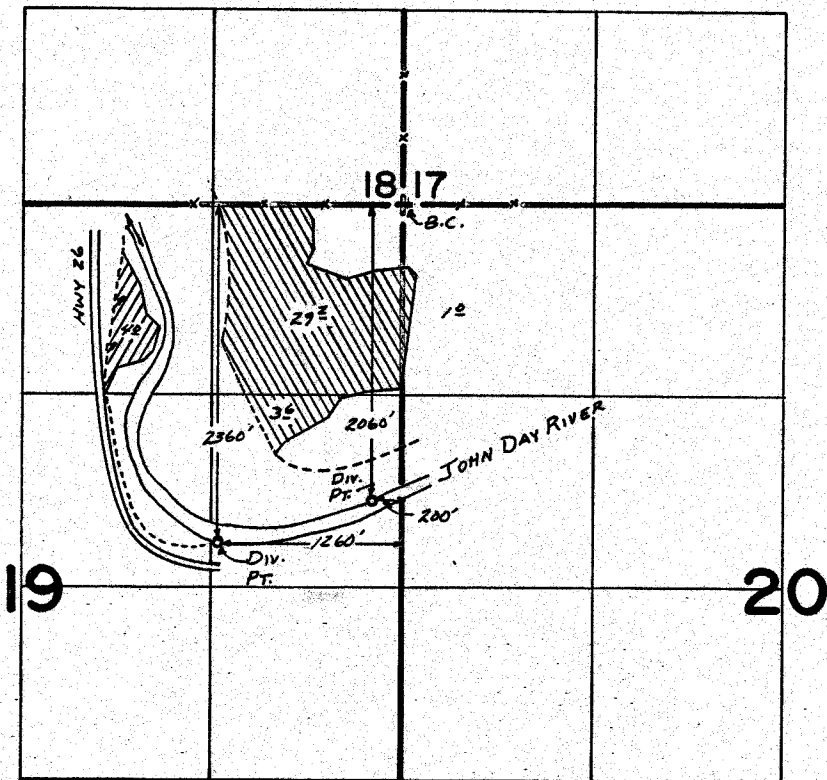

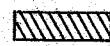


# T. 13S., R. 29E. W.M.



 App. 38502  
 App. 37518

## FINAL PROOF SURVEY UNDER

Application No. 37518 Permit No. 28026  
 Application No. 38502 Permit No. 28663...  
 IN NAME OF

*Ralph & Jean Burrows*

Surveyed June 14 1978, by J.S. Donaldson.