28663

50974

T. 13S., R. 29E. W.M.

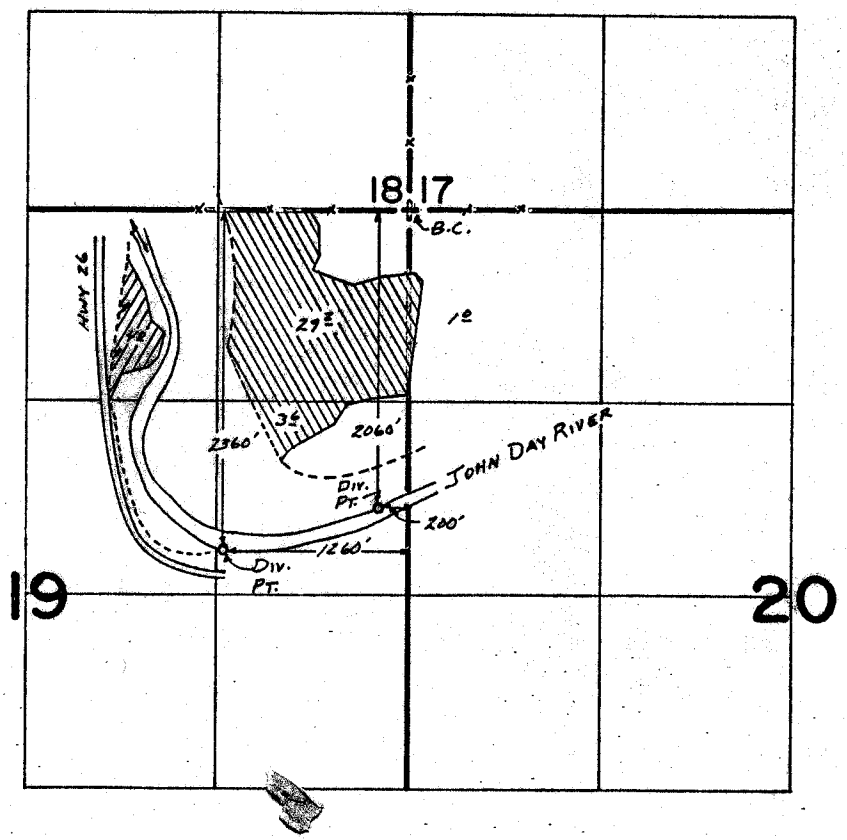

App. 38502

App. 37518

FINAL PROOF SURVEY
UNDER

Application No. 37518 38502... Permit No. 28026 28663...

IN NAME OF

Ralph & Jean Burrows

Surveyed June 14 1978., by J.S. Donaldson

PTS-1978-A-Bell.