


T. 108&11S. R. 34E. W. M.

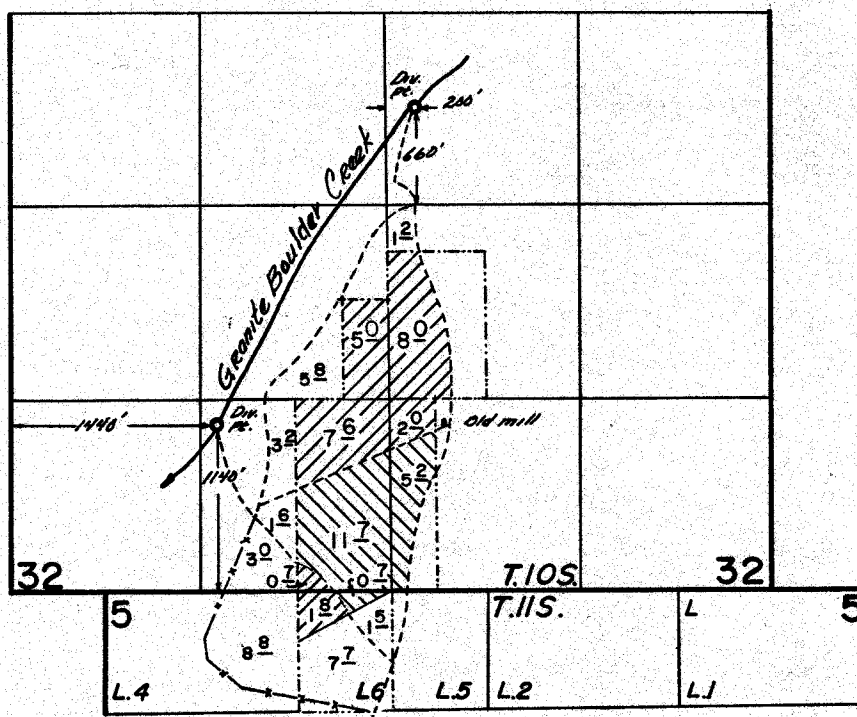

 SUPPLEMENTAL
 PRIMARY

FINAL PROOF SURVEY

Application No. **57.453..** Permit No. **.43320.....**
IN NAME OF

DAN W. LUFKIN

Surveyed July 14... 1979, by S.C. BROWN.....