


T23S. R31E. WM.

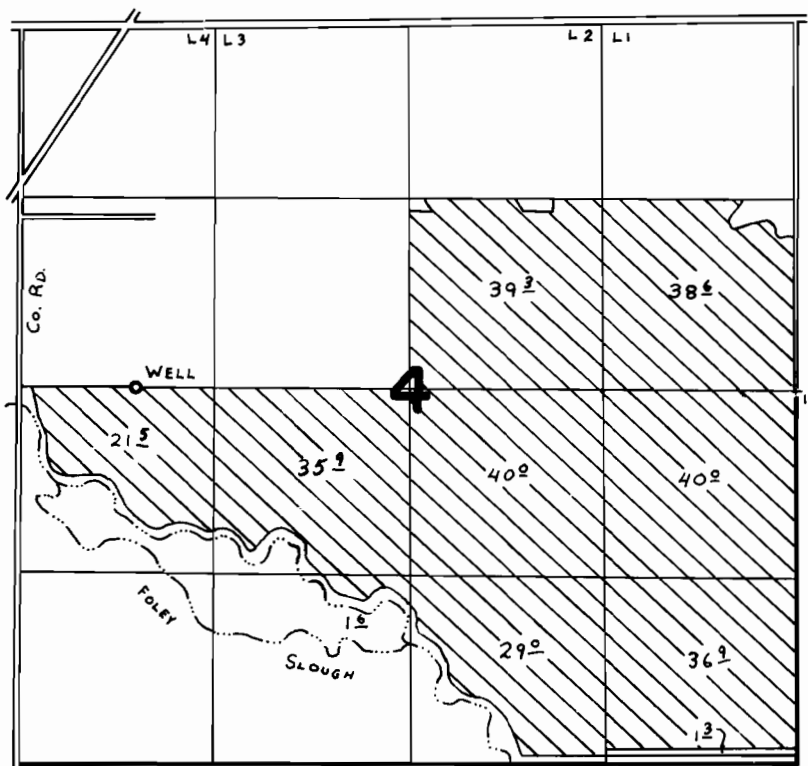

WELL LOC.: 4530' W. fr. E. $\frac{1}{4}$ COR. SEC. 4.

FINAL PROOF SURVEY
UNDER

Application No. G-8342 Permit No. G-7766
IN NAME OF

TYLER BROTHERS

Surveyed AUG. 25 1978, by C. L. HUGHES