


T.23S.,R.31E.,W.M.

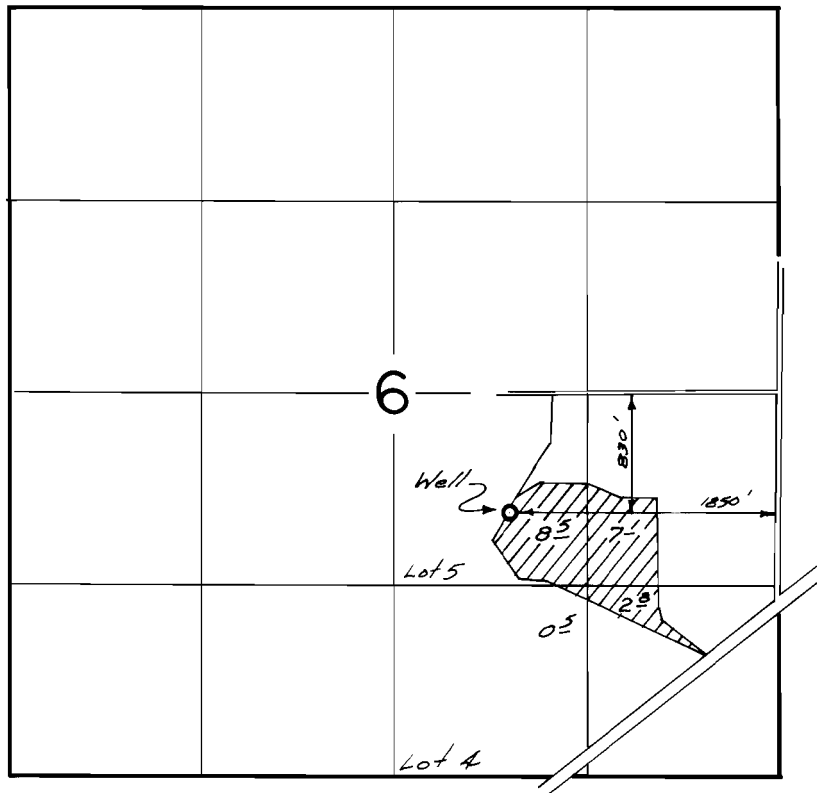

FINAL PROOF SURVEY UNDER

Application No. G-8457 Permit No. G-8160
IN NAME OF

EARL TILLER

Surveyed July 28, 1979, by R.G. MUCKEN