


T.37 S., R. 4 W., W. M.

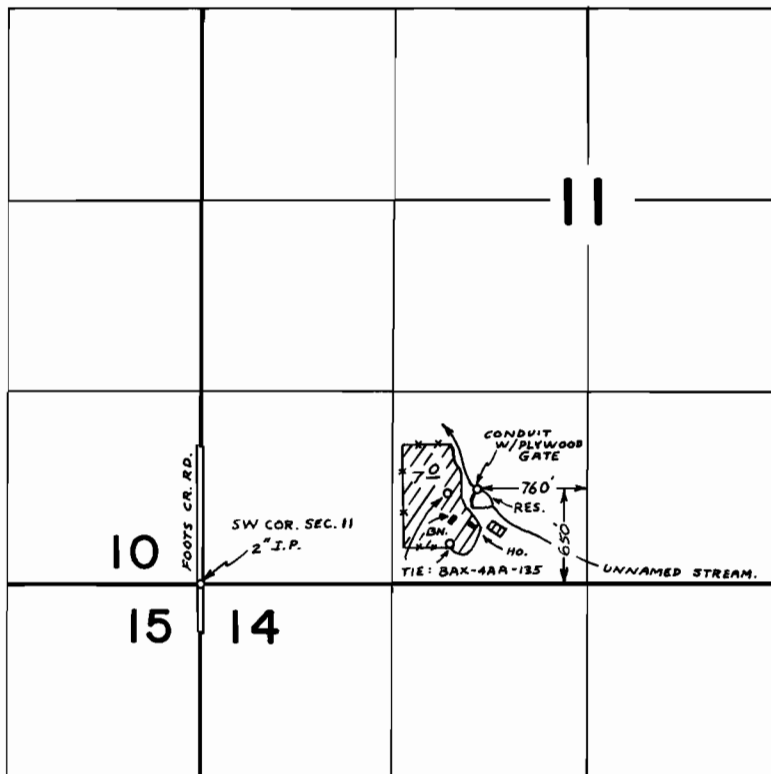

FINAL PROOF SURVEY UNDER

Application No. R-54072 Permit No. R-6465
 54073 40488
 IN NAME OF

GEORGE W. &/OR HARRIET B. OACHS

Surveyed SEPT. 22 1978, by B. SUND