


T.35 S., R.1 W., W.M.

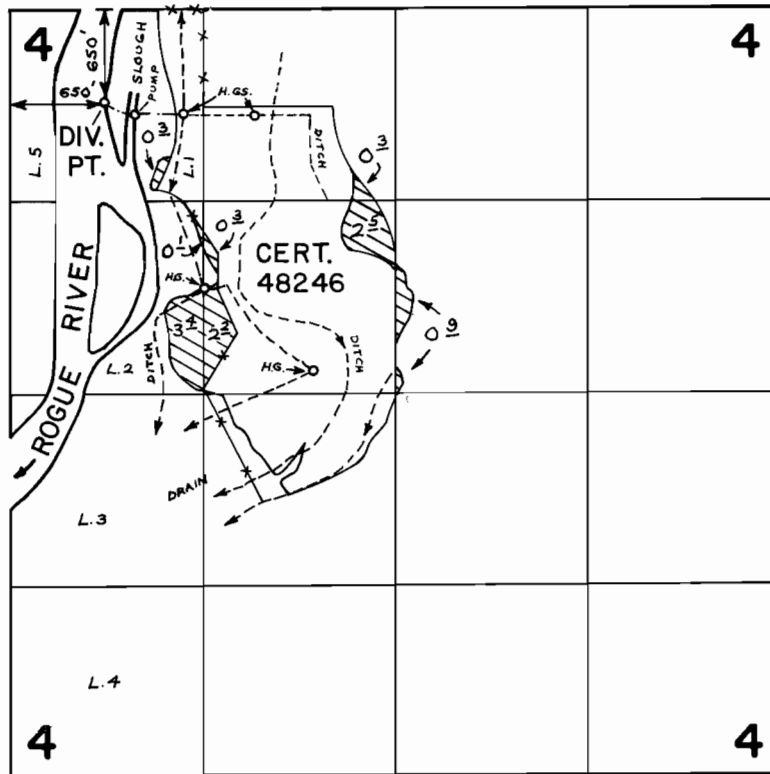

FINAL PROOF SURVEY UNDER

Application No. 42956 Permit No. 32092

IN NAME OF

FLEMING BROS. CORP.

Surveyed DEC. 13 1979, by B. SUND

D.H.M.
PHOTO: 62 (E.P.I.D.)