


T. 36 S., R. 3 W., W.M.

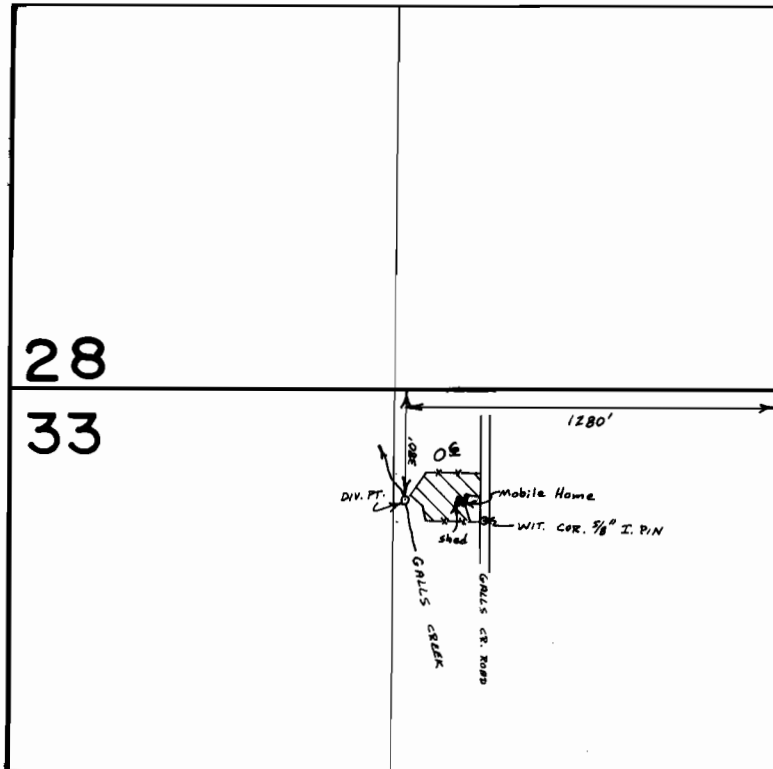

Scale : 1" = 660'

**FINAL PROOF SURVEY**  
UNDER

Application No. 52334 Permit No. 39360  
IN NAME OF

LOUIS C. GRAY

Surveyed Sept. 22, 1978, by B. R. SUND