


# T.37&38 S., R.4 W., W.M.

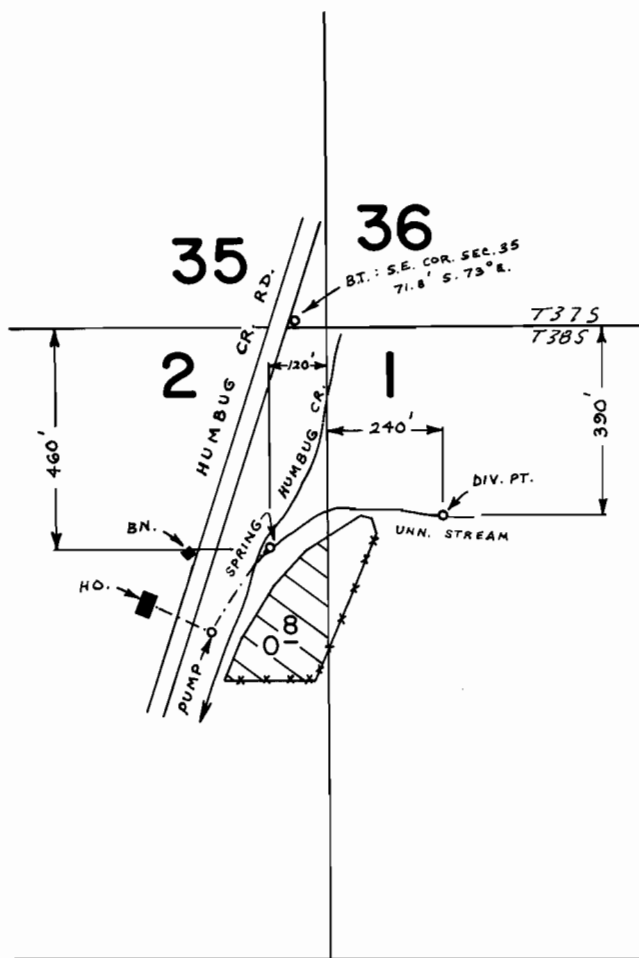

SCALE: 1" = 400 FT.

## FINAL PROOF SURVEY UNDER

Application No. 53222 Permit No. 39494  
IN NAME OF

*Roger D. & Janet A. Abrahams*

Surveyed JUN. 5 1979, by B. SUND

D.H.M.  
P.T.S. - 1979 - 14 - B