


T. 35 S., R. 2 W., W.M.

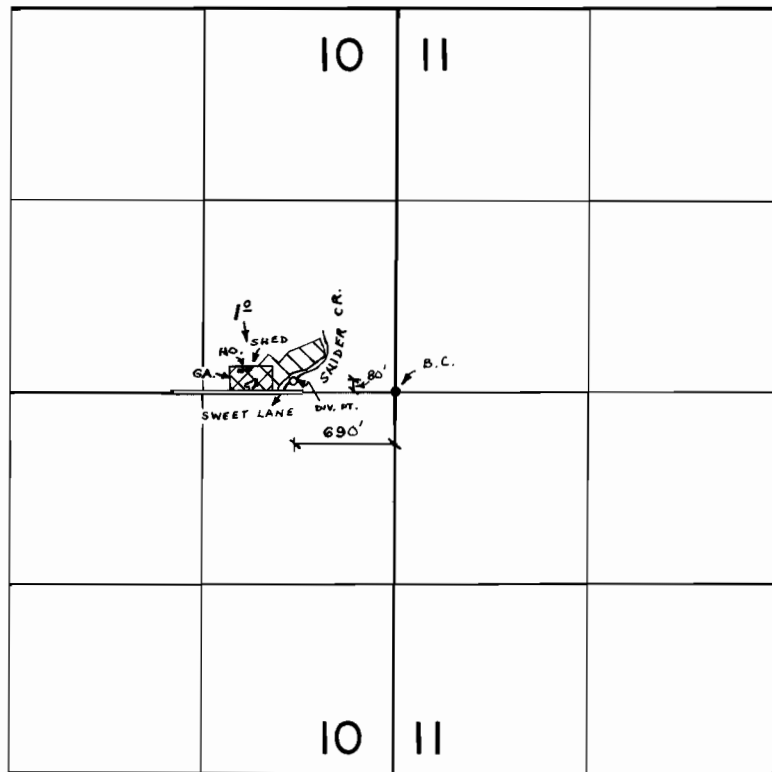

FINAL PROOF SURVEY
UNDER

Application No. 55555 Permit No. 41859
IN NAME OF



LLOYD S. &/OR THELMA A. BEERS

Surveyed NOV. 2 1978, by B. SUND

D.H.M.
PTS-1978-14-D