


T. 36 S., R. 4 W., W. M.

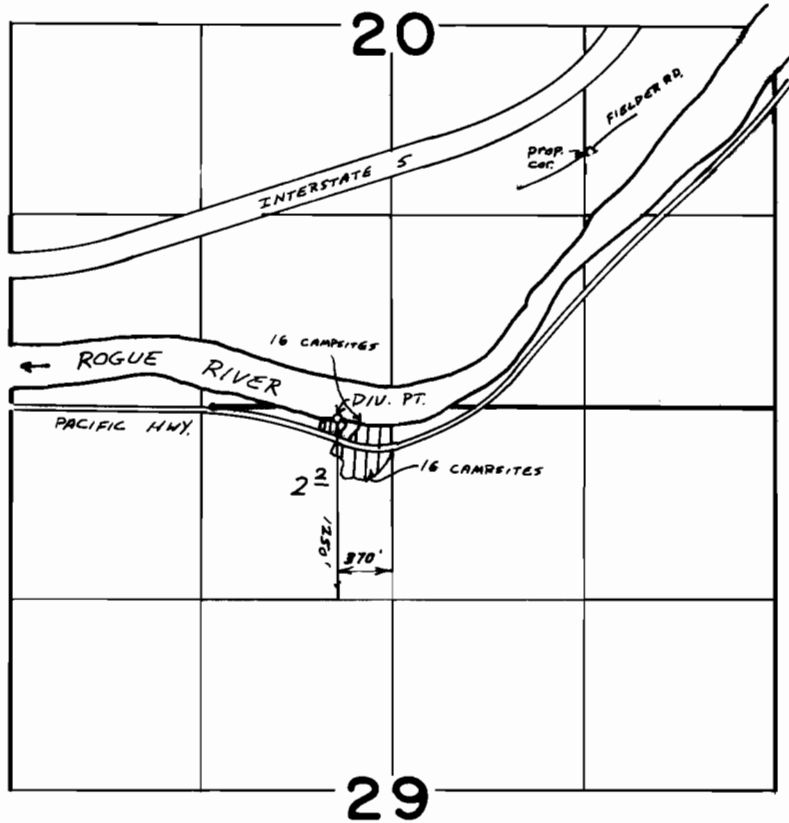

**FINAL PROOF SURVEY**  
UNDER

48036                      36022

Application No. 55.97.4. Permit No. 4.1936.....

IN NAME OF

EARL E. & KATHERINE PAPE.....

Surveyed FEB. 23, 1978, by B.R. SUND.....