


T.35 S., R.18 & 2 W., W.M.

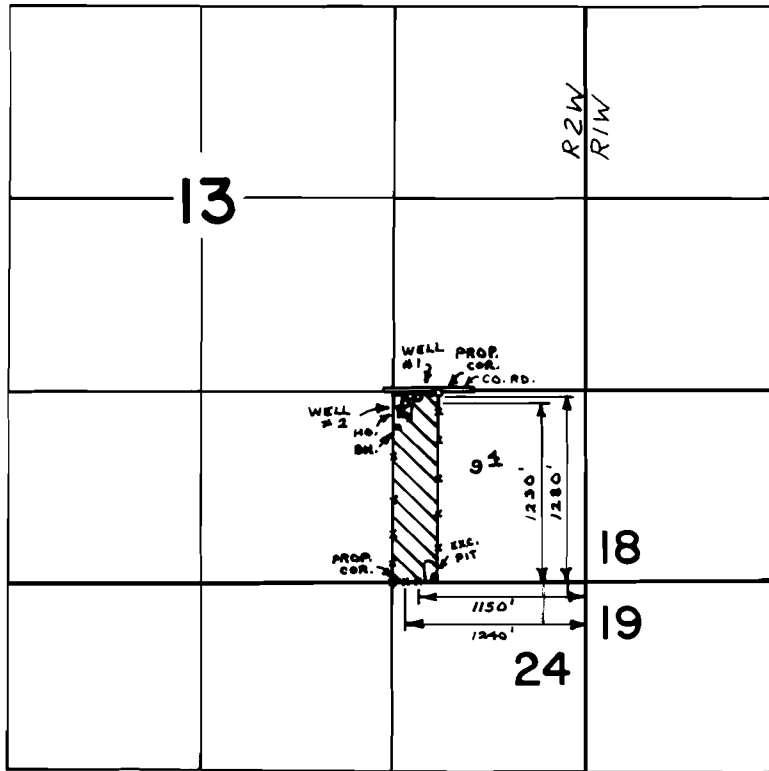

FINAL PROOF SURVEY
UNDER

Application No. G-5185 Permit No. G-5056
IN NAME OF

Clifford and/or Sheila Bartyzal

Surveyed JUN. 1 1978, by B. SUND

D.H.M.
P.T.S.-1978-14-A