


T. 37 S., R. 5 W., W. M.

25

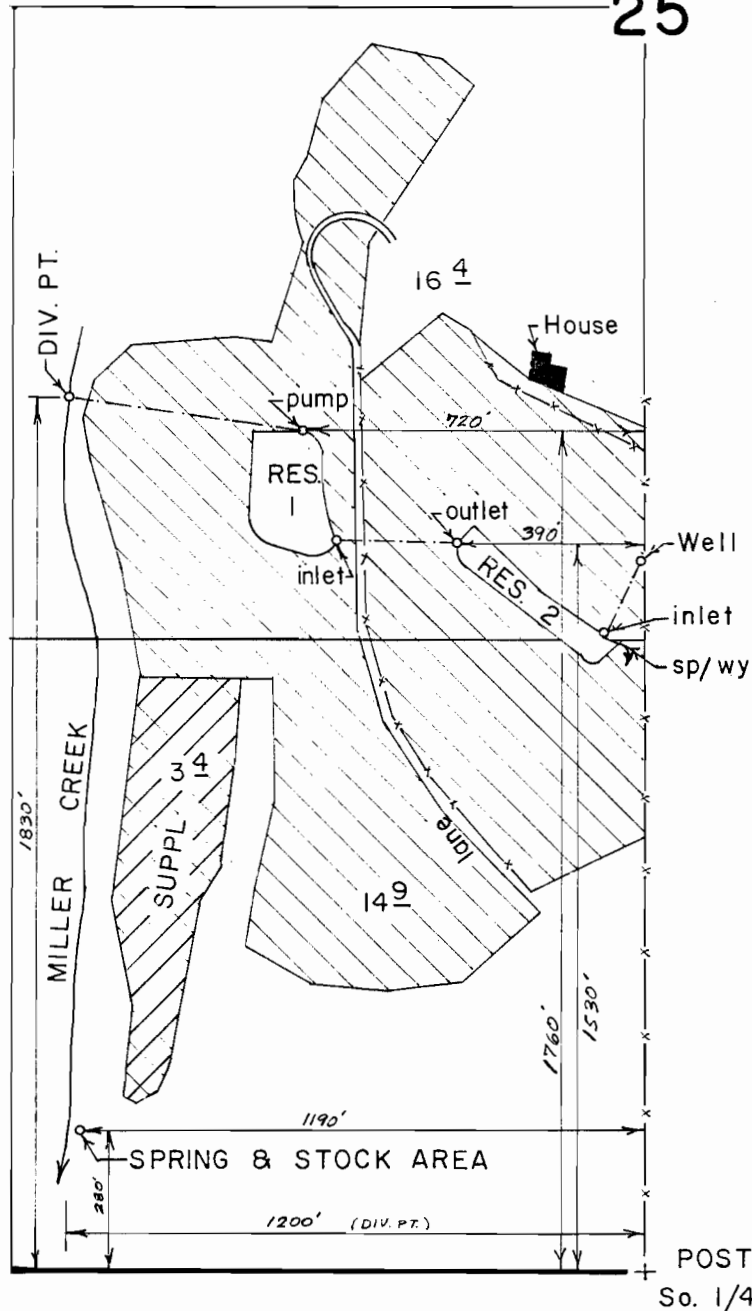

FINAL PROOF SURVEY


UNDER

53428

R-52378

39378

R-6302

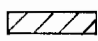 Suppl

Application No. 52379. Permit No. 39367.....

 Primary

IN NAME OF

WILLIAM H. & RUTH A. SPENCER

Surveyed JUNE 21 1979, by B. R. SUND.....

Scale: 1" = 400'