


T. 35 S., R. 6 W., W.M.

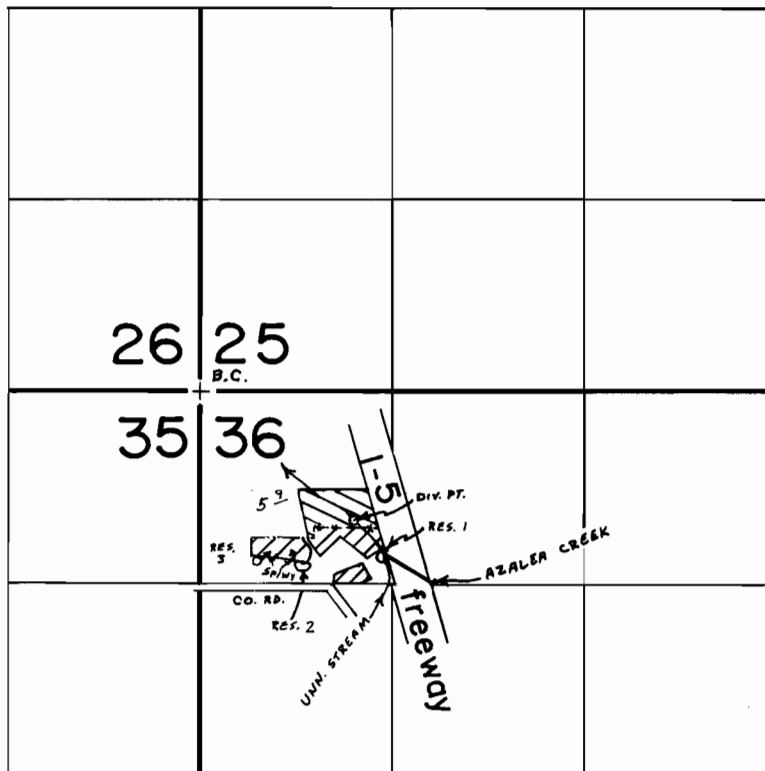

DIV. PT. : 860'S & 1050'E ; RES. 1 : 1100'S & 1250'E ;
RES. 2 : 1160'S & 660'E ; RES. 3 : 1130'S & 390'E, ALL
FROM NW COR. SEC. 36.

Scale 4" = 1 mile

FINAL PROOF SURVEY UNDER

R-48299 R-5874
Application No. ~~48300~~ Permit No. ~~36269~~.....
IN NAME OF

.....MARGARET K. WOOD.....

Surveyed Nov. 1, 1977, by B.R. SUND.....