


T.14S.,R.11W.,W.M.

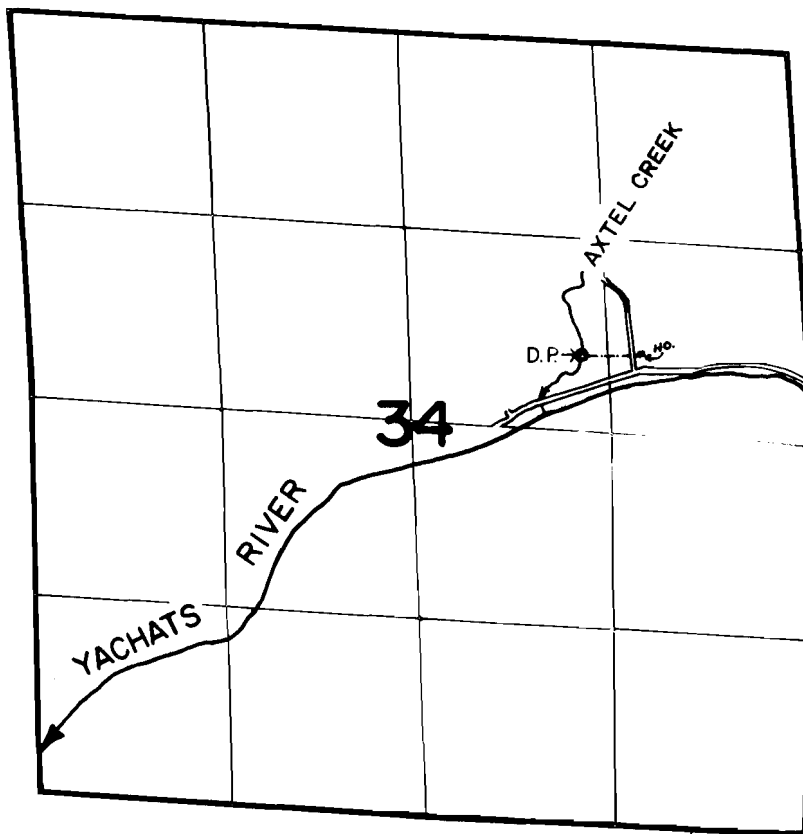

POINT OF DIVERSION LOCATED: 520' North & 1580' West of the
East Quarter Corner, Section 34

FINAL PROOF SURVEY UNDER

Application No. 58531.. Permit No. 44184.....
IN NAME OF

.....*Marvin K. & Lady Hendrickson*.....

Surveyed Sept. 25 1979, by S.C. BROWN.....