


WATER LINE TRAVERSE

TRAVERSE NO.	BEARING	DISTANCE	TRAVERSE NO.	BEARING	DISTANCE
OAK	N 27° 46' 30" W	84.83'	44	N 60° 56' 06" W	143.72'
41	N 27° 46' 30" W	24.25'	45	N 53° 11' 42" W	52.36'
42	N 31° 00' 18" W	150.57'	46	N 66° 09' 18" W	64.62'
43	N 25° 26' 42" W	212.71'	47	N 54° 32' 12" W	149.49'
			48	N 22° 39' 00" W	72.73'

PT. OF DIV.

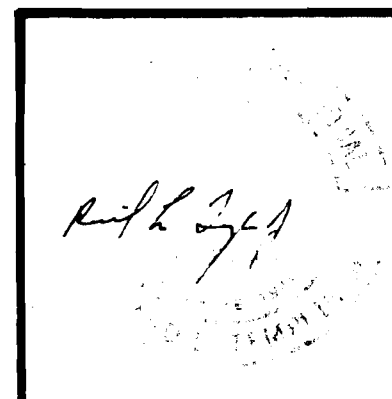

RICHARD L. TEMPLIN
CONSULTING ENGINEER

PLAT OF SURVEY
SURFACE WATER APPLICATION

LOCATED IN
SECTIONS 20, 21 & 28, T.33S., R.5W., W.M.
JOSEPHINE COUNTY, OREGON

Surveyed For: Betty Hofflinger *Betty Hofflinger*
Scale: 1" = 400' *Permit # 36318* Nov. 22, 1974.