


# T.36 S., R.5 W., W.M.

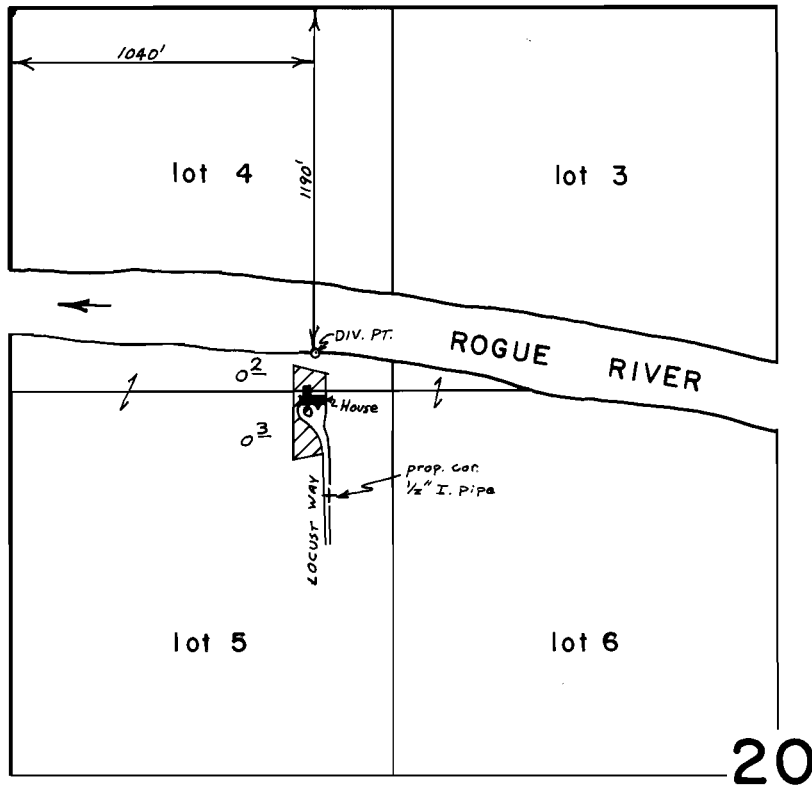

scale : 1" = 660'

## FINAL PROOF SURVEY UNDER

Application No. 55613... Permit No. 42667.....  
IN NAME OF

.....JACK..... MAHNKEN.....

Surveyed JUNE..22,1978., by B.R.SUND.....