


T. 36 S., R. 7 W., W.M.

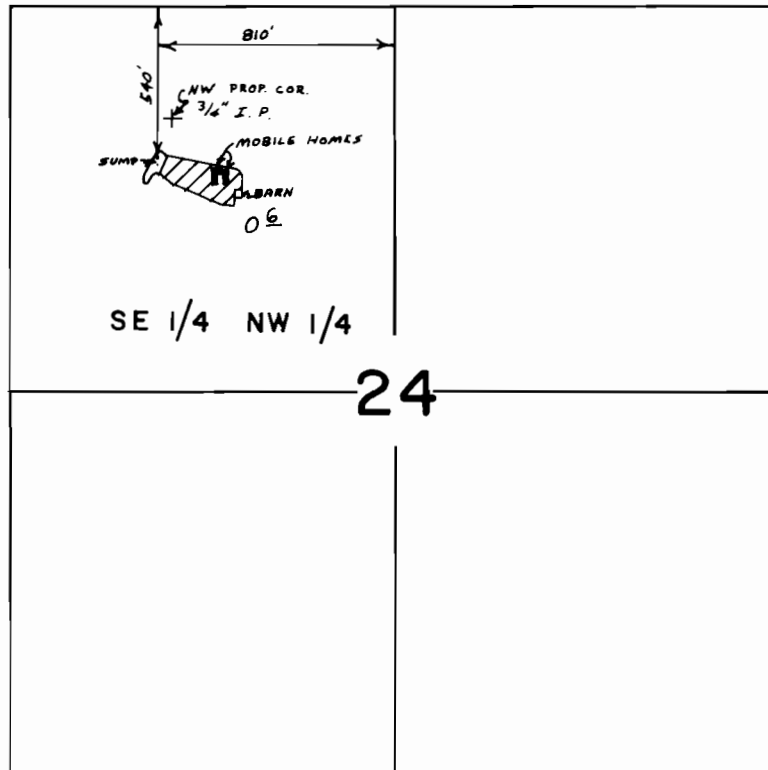

scale : 1" = 660'

FINAL PROOF SURVEY
UNDER

Application No. G-6093 Permit No. G-5775
IN NAME OF

RAYMOND S. PANULA

Surveyed Oct. 23, 1978, by B.R. SUND