


T. 37 S., R. 5 W., W.M.

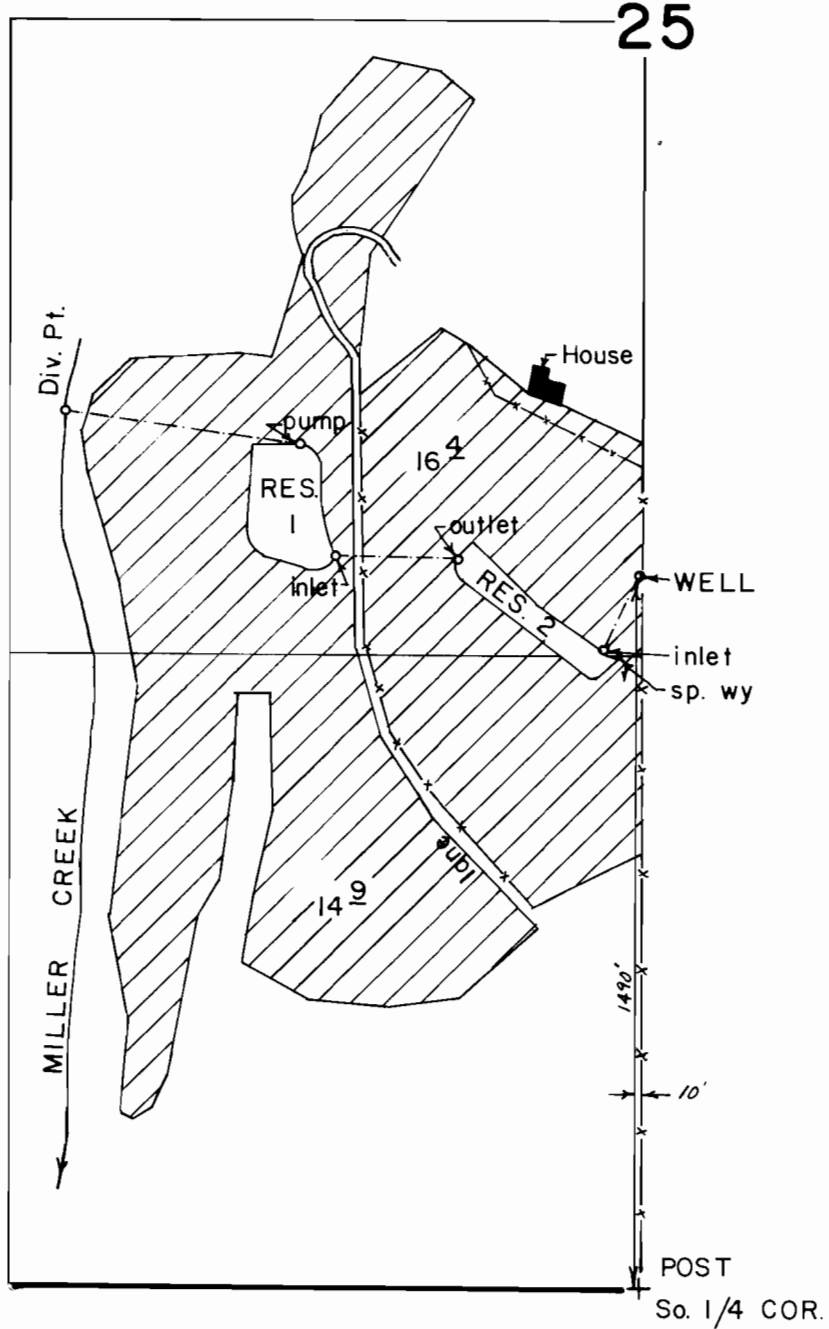

FINAL PROOF SURVEY
UNDER

Application No. G-7033 Permit No. G-6338...
IN NAME OF

WILLIAM H. & RUTH A. SPENCER

Surveyed JUNE 21, 1979, by B. R. SUND

Scale: 1" = 400'