


T.39S. R.19E. W.M.

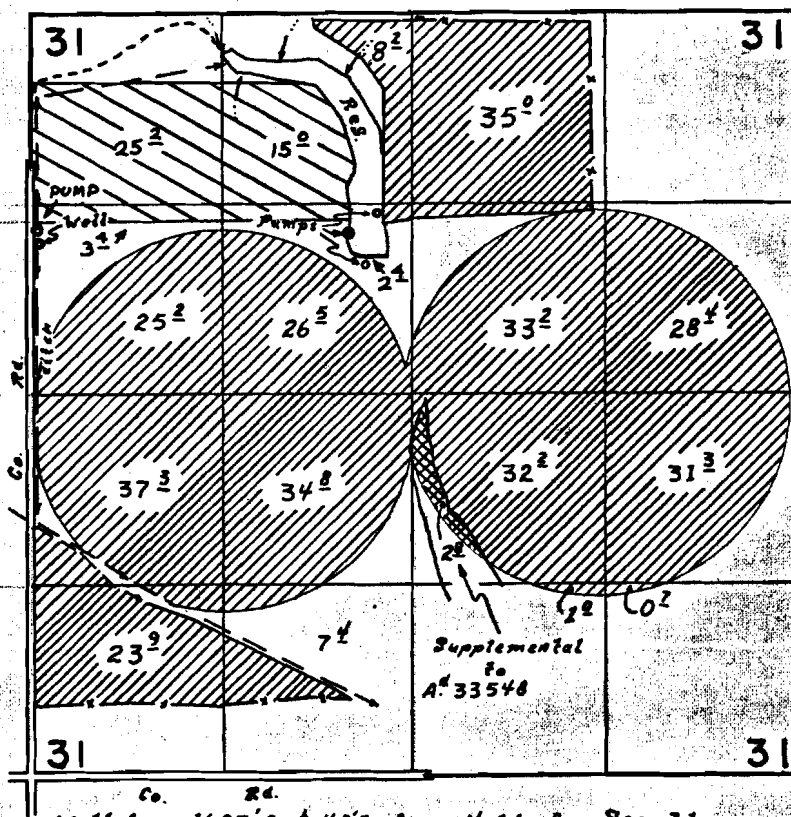

Supplemental 
Primary 

FINAL PROOF SURVEY

UNDER

G-7209

G-6636

G-5705

G-5514 

Application No. G-5101 Permit No. G-4812
IN NAME OF

Clyde W. Fenimore

Surveyed 18 Sept. 1972, by L.E. Gould
Oct. 23, 1976 R.G. Mucken