


G 7648  
51013

# T39S. R24E. WM.

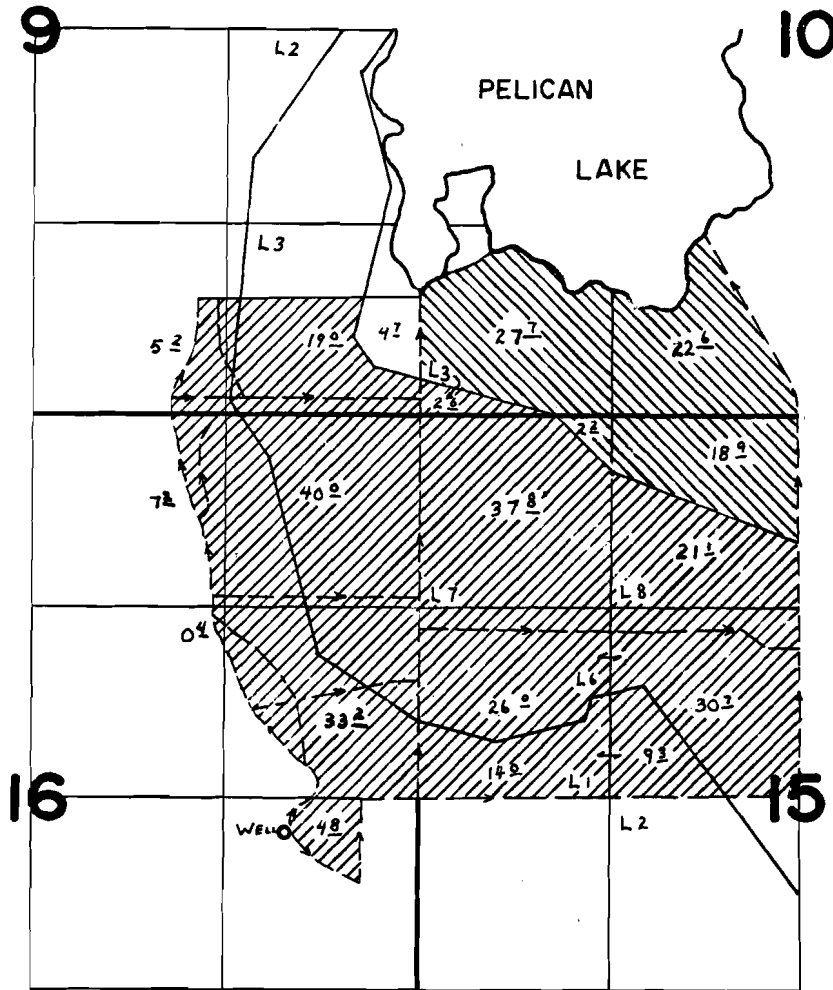

WELL LOC: 230'S & 130'W fr. E 1/4 COR SEC 16.  
▨ - PRIMARY IRRIGATION  
▨ - SUPPLEMENTAL IRRIGATION

## FINAL PROOF SURVEY UNDER

Application No. G-8162 Permit No. G-7648  
IN NAME OF

O'KEEFE & SON

Surveyed JUNE 28 1978, by C. L. HUGHES

G# 51013