


T.15S. R.1W., W.M.

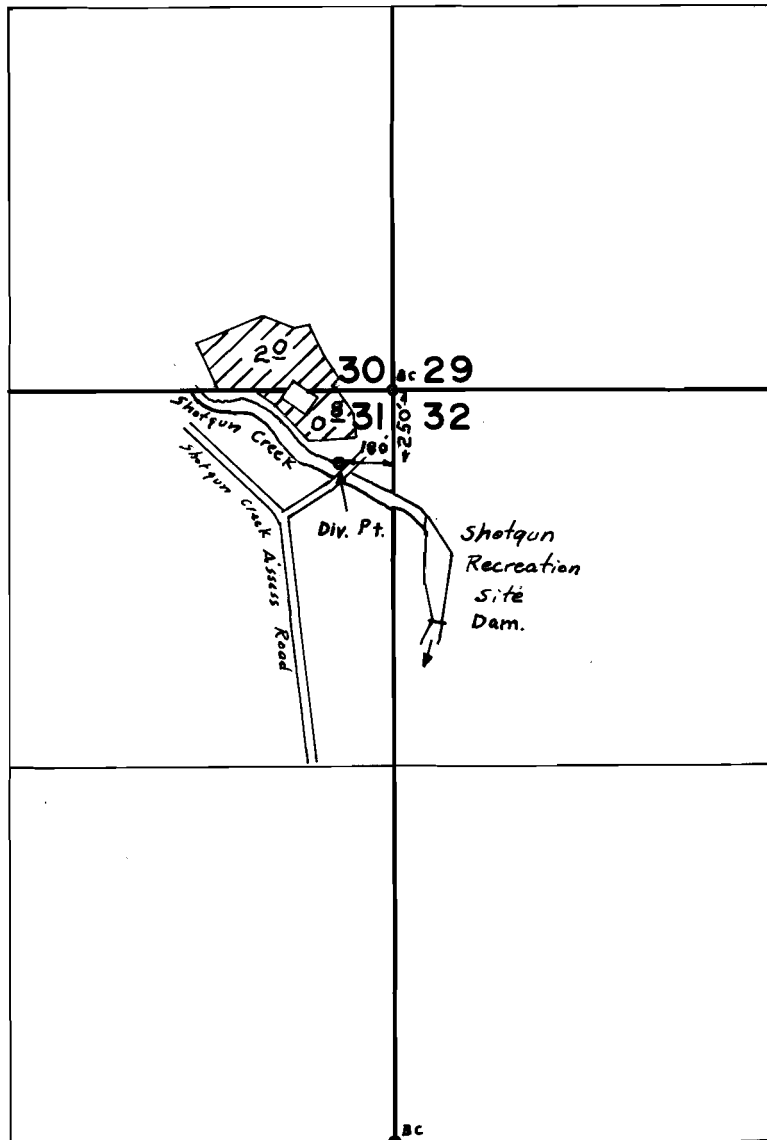

Reservoir: 750'S & 150'E from NW cor Sec 32

Scale: 1" = 660

FINAL PROOF SURVEY UNDER

R-52074 R-6125
Application No. 52075 Permit No. 37843
IN NAME OF

..... BLM - U.S.D.I.

Surveyed MAY 17 1978, by J.S. DONALDSON