T.15S. R.1W., W.M.

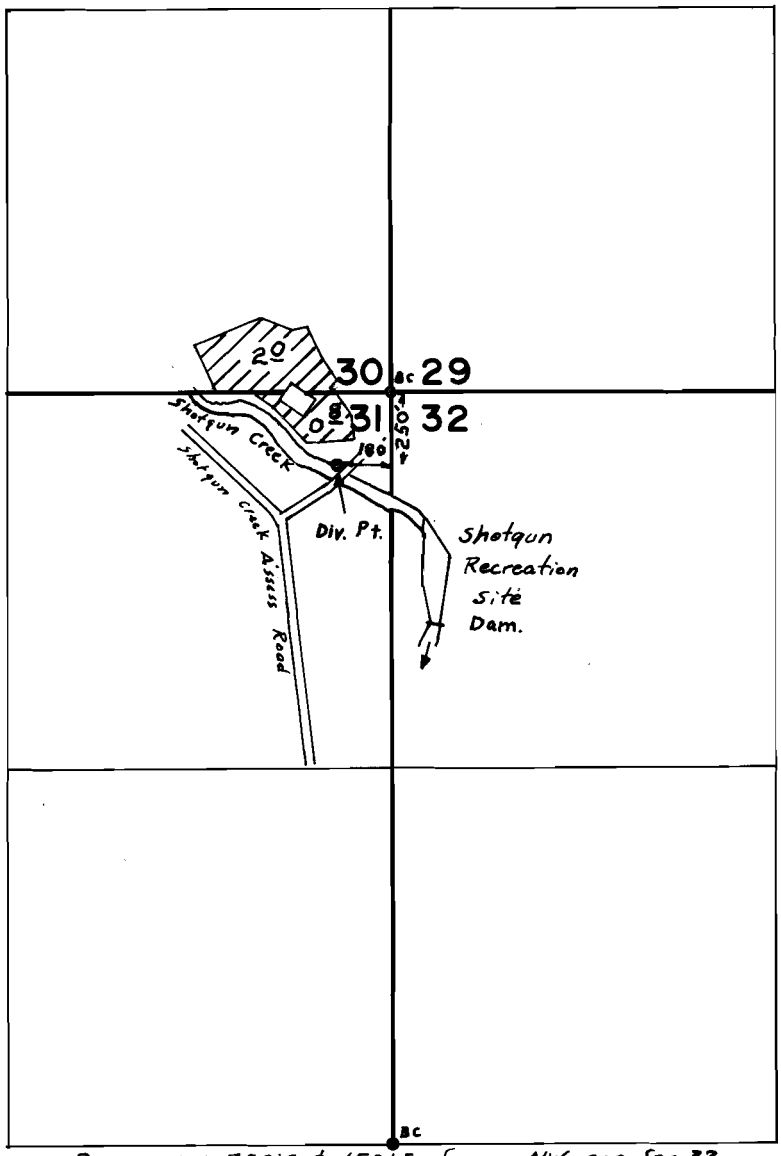

Reservoir: 750'S & 150'E from NW cor Sec 32

Scale : 1" = 660

FINAL PROOF SURVEY
UNDER

Application No. R-52074 52075 Permit No. R-6125 37843

IN NAME OF

BLM-U.S.D.I.

Surveyed MAY 17 1978, by J.S. DONALDSON

1978-A-2