


T.15S. R.5 W., W.M.

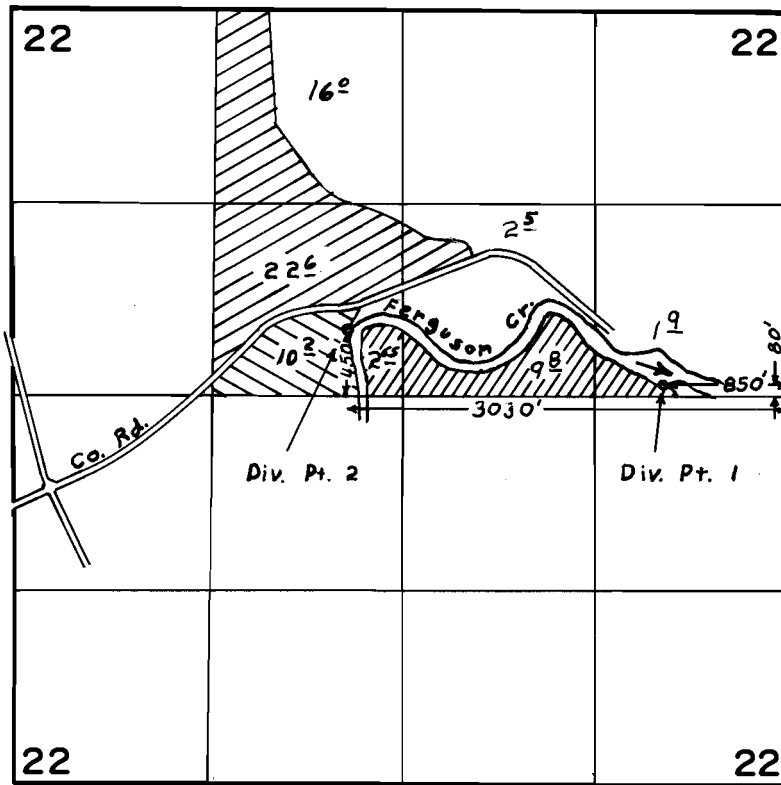

	<i>App'l.</i>	50865
	<i>App'l.</i>	52943
	<i>App'l.</i>	53176

FINAL PROOF SURVEY

UNDER

50865 37785
 52943 38809
 Application No. 53176 Permit No. 38812
 IN NAME OF

RONALD E. DETERING

Surveyed APR. 25. 1978, by J.S.DONALDSON