


T.15S. R.5 W., W.M.

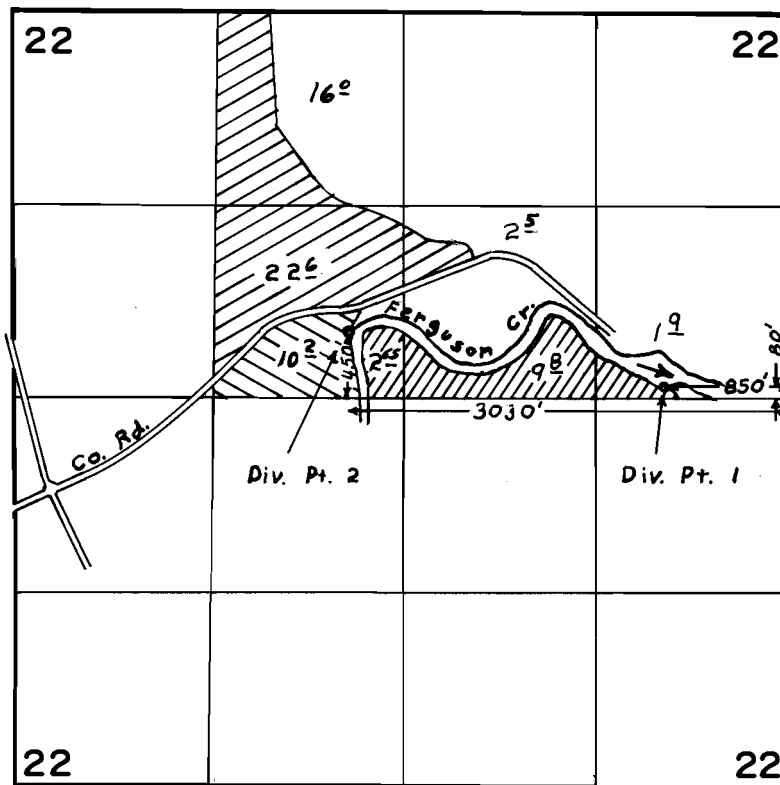

 App'l. 50865
 App'l. 52943
 App'l. 53176

FINAL PROOF SURVEY UNDER

50865 37785
 52943 38809
 Application No. 53176 Permit No. 38812
 IN NAME OF

RONALD E. DETERING

Surveyed APR. 25. 1978, by J. S. DONALDSON