


T18S. R7W. WM.

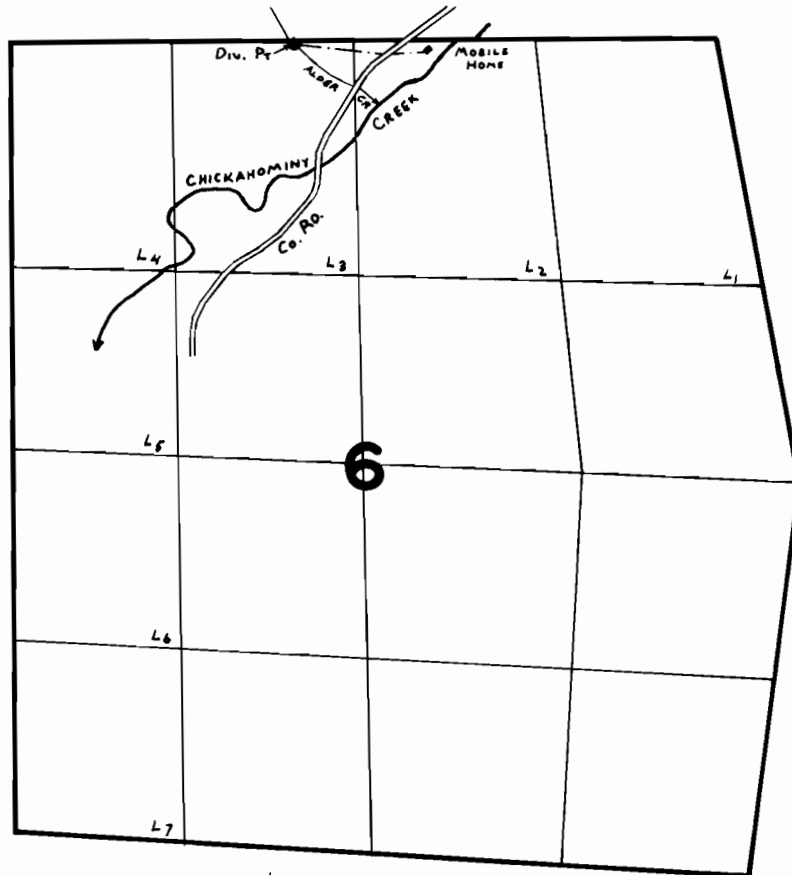

Div. Pt. Loc: 25'S. & 406±' W fr. N. 1/4 COR. SEC. 6.

FINAL PROOF SURVEY UNDER

Application No. 52471 Permit No. 39453
IN NAME OF

JOHN ROBERTSON

Surveyed JUNE 14 1978, by C. L. HUGHES