


# T.18S. R.1W. W.M.

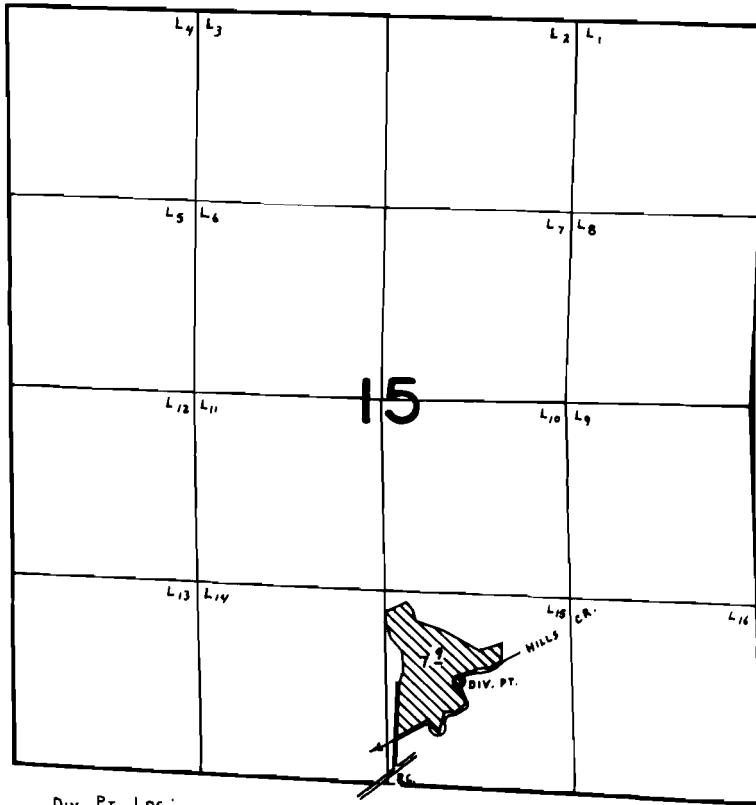

Div. Pt. Loc:  
710' N. & 500' E. fr. S. 1/4 COR. SEC. 15.

## FINAL PROOF SURVEY UNDER

Application No. 53858. Permit No. 40193.....  
IN NAME OF

.....Michael P. Baker.....

Surveyed June 19, 1980, by G.L. Hughes.....