


T.15S. R.4W., W.M.

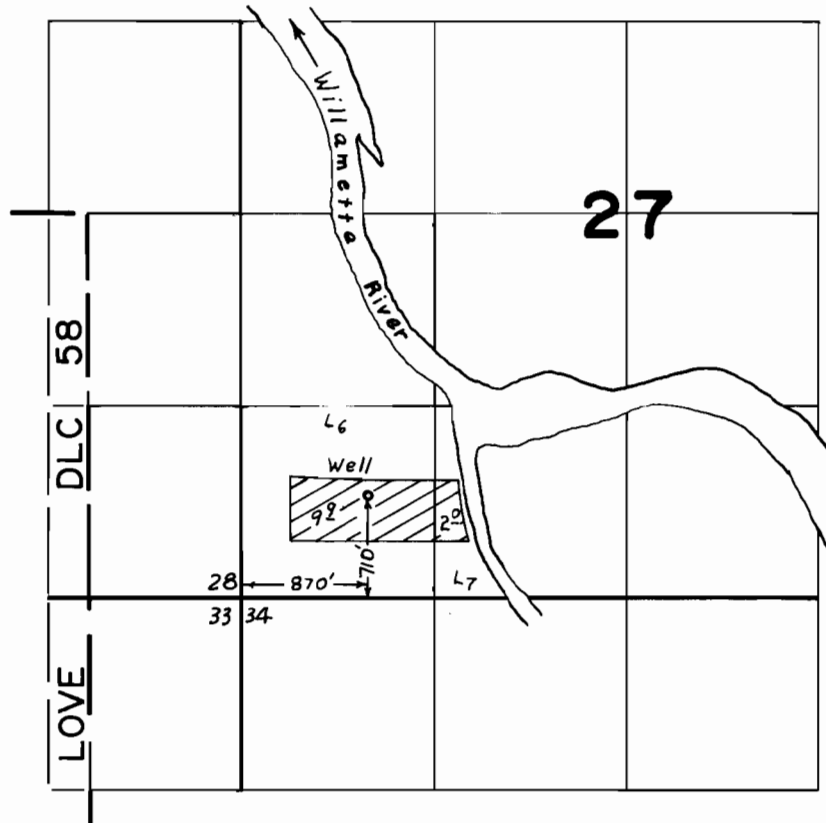

FINAL PROOF SURVEY UNDER

Application No. G-6812 Permit No. G-6315
IN NAME OF

..... DAVID WILCOX

Surveyed APR. 25 1978, by J.S. DONALDSON