


G6875
51027

T38S. R19E. WM.

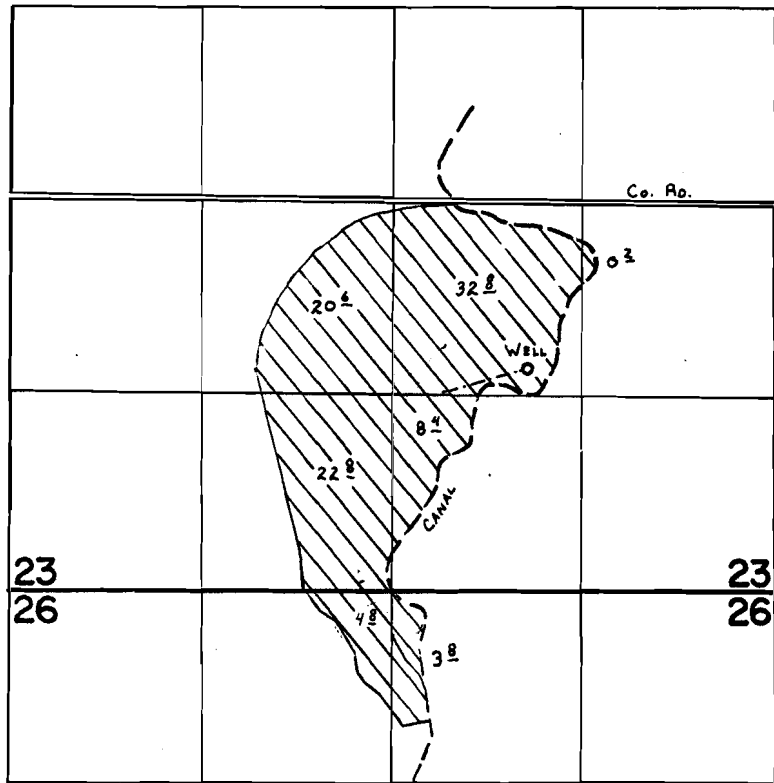

WELL LOC: 1530' N. & 1700' W. fr. S.E. COR. SEC. 23.

FINAL PROOF SURVEY UNDER

Application No. G-7394 Permit No. G-6875
IN NAME OF

BURMUDA RESEARCH CORP.

Surveyed JUNE 27 1978, by C. L. HUGHES