


T. 10 S., R. 4 W., W.M.

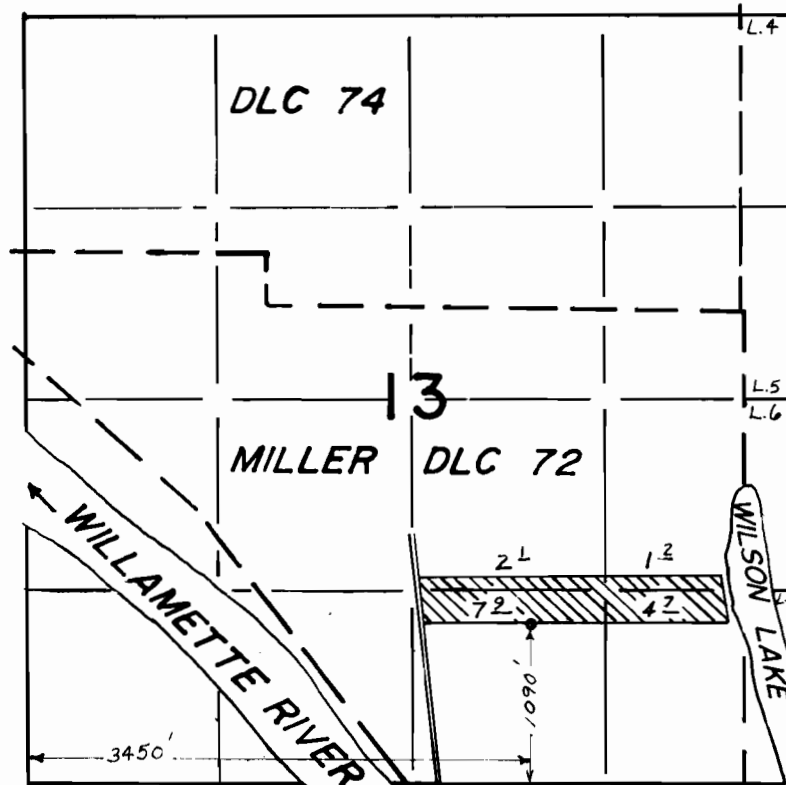

**FINAL PROOF SURVEY**  
UNDER

Application No. G-8739. Permit No. G-8084.  
IN NAME OF

.....RICHARD D. GRAY.....

Surveyed Sept. 5.... 1978, by J.S. DONALDSON