


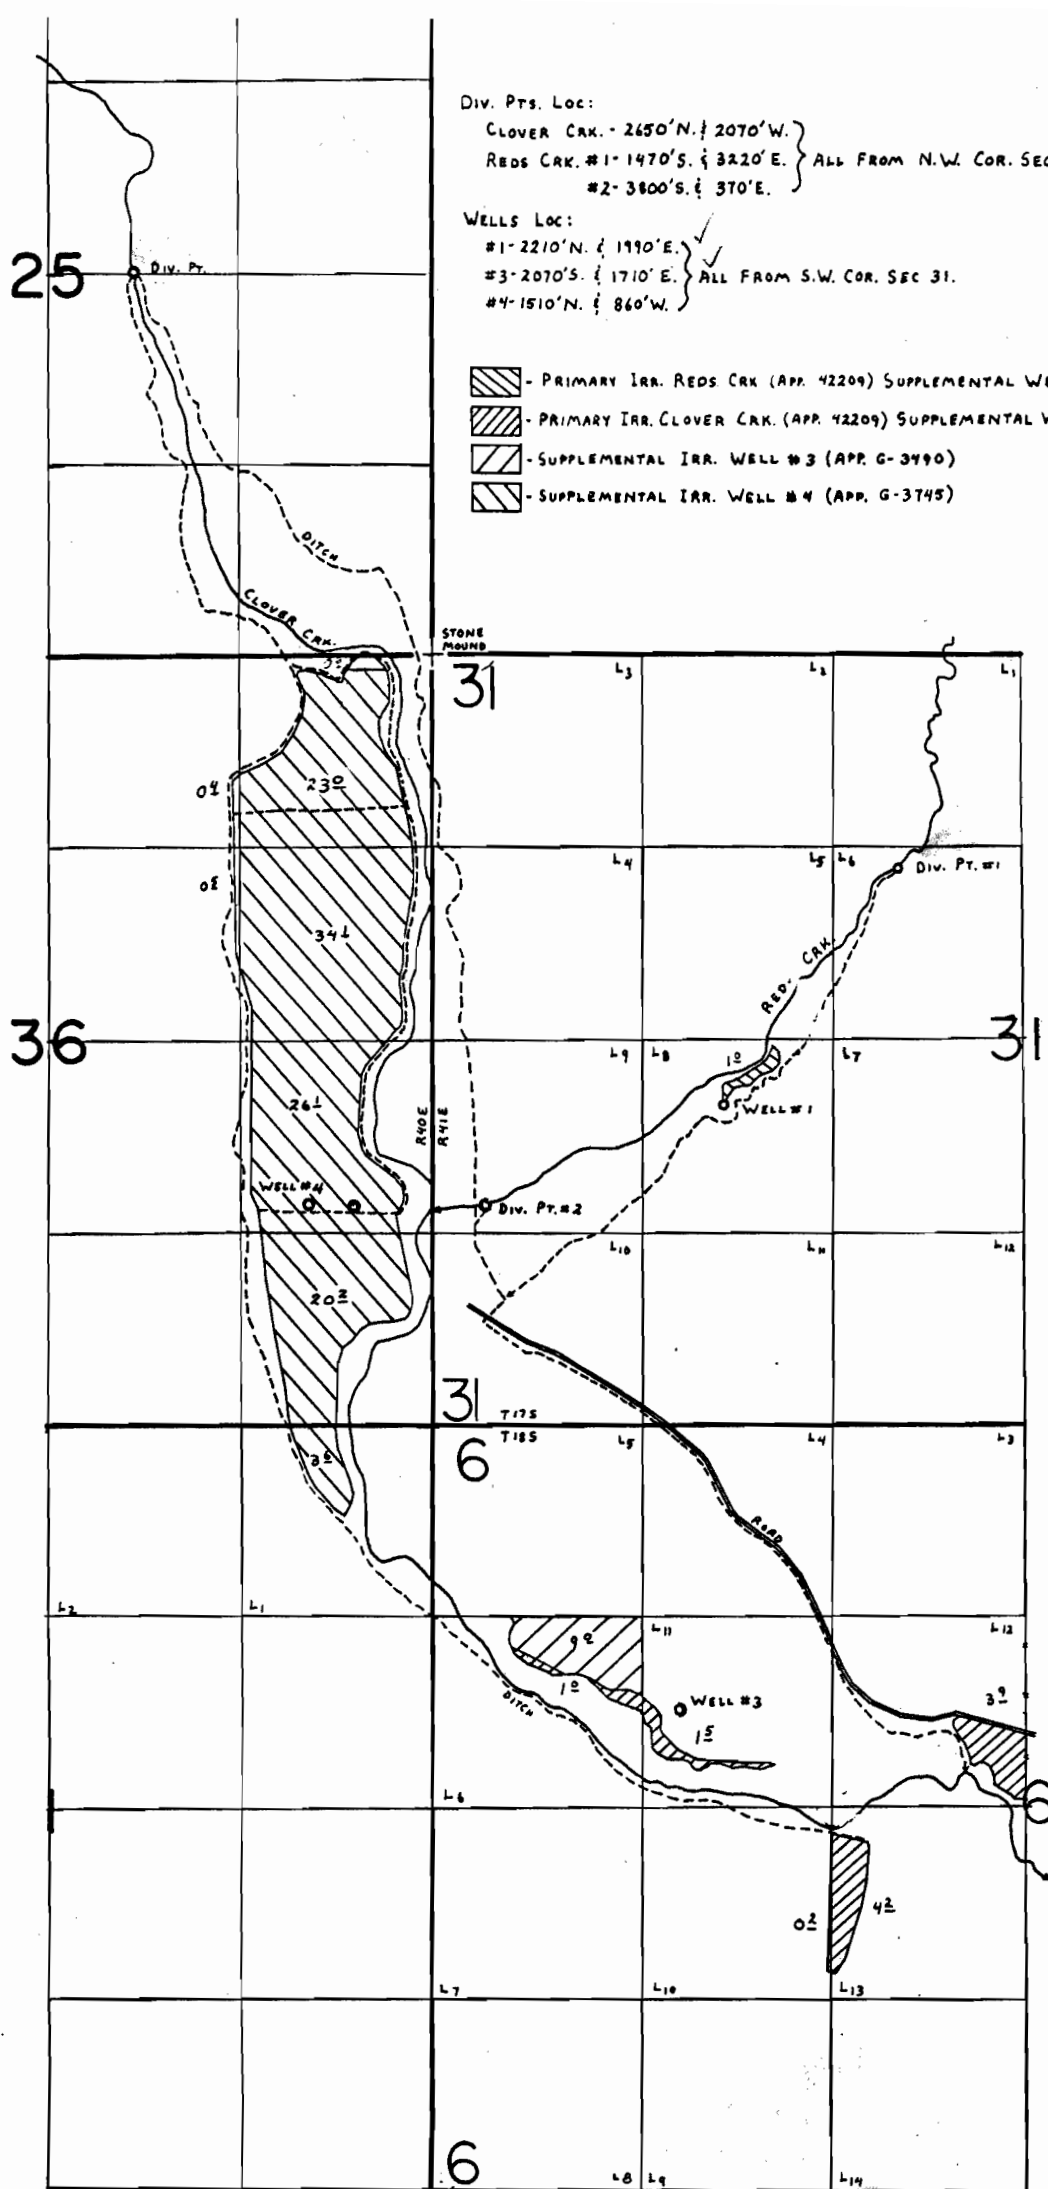

FINAL PROOF SURVEY

UNDER

TRANSFER NO. J-43

APPLICATION NO. 42209 PERMIT NO. 31962
 G-3490 G-3350
 G-3745 G-3537

IN NAME OF

JORDAN CATTLE CO.

SURVEYED AUG. 2, 1979, by C L HUGHES