


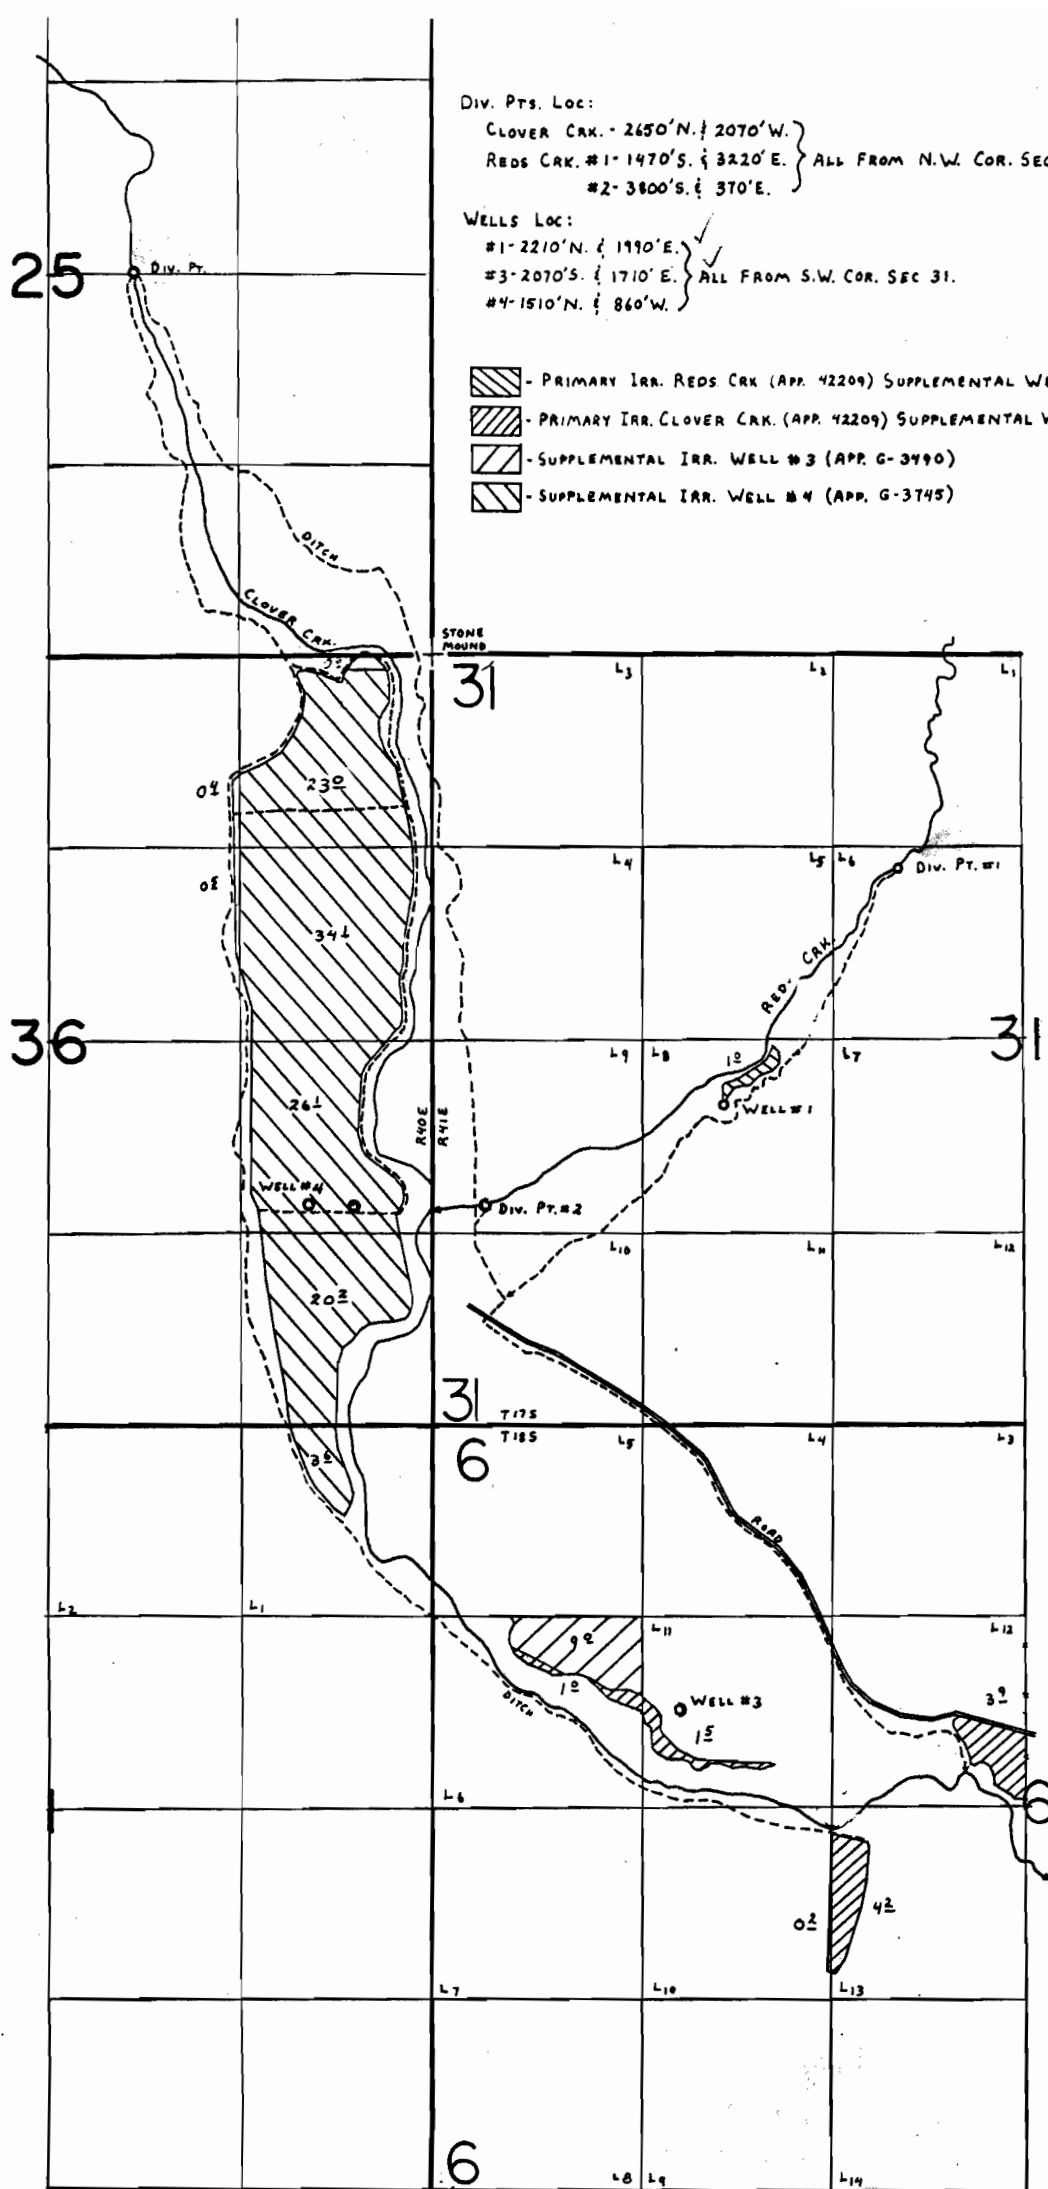

# FINAL PROOF SURVEY

UNDER

TRANSFER NO. J-43

APPLICATION NO. 42209

PERMIT NO. 31962

G-3490

G-3350

G-3745

G-3537

IN NAME OF

JORDAN CATTLE CO.

SURVEYED AUG. 2, 1979, by C L HUGHES