


T.15S., R.42 & 43E., W.M.

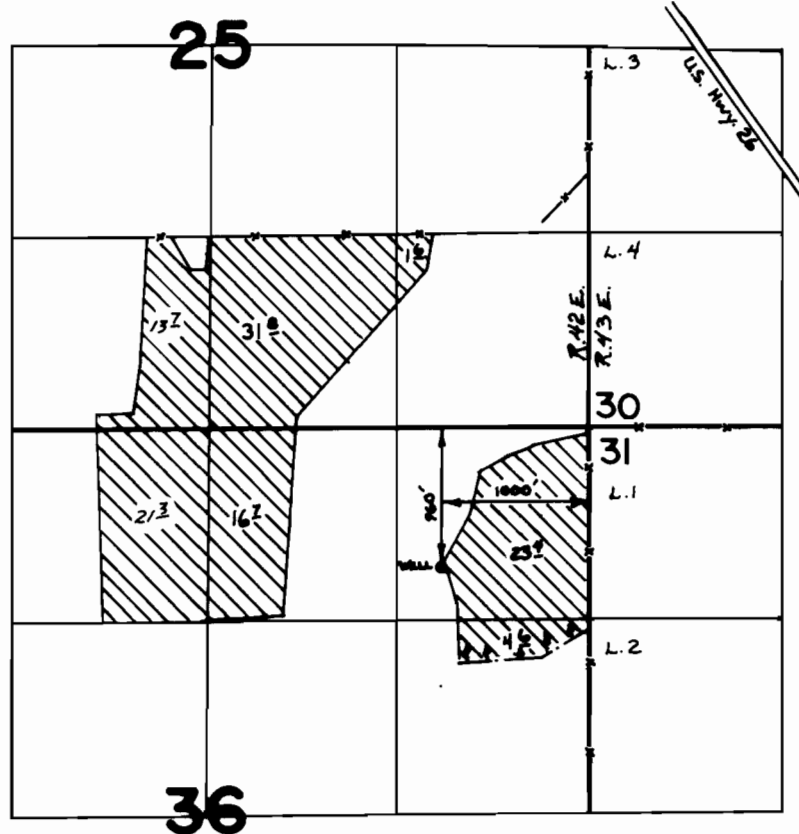

FINAL PROOF SURVEY UNDER

Application No. G-5849 Permit No. G-5590
IN NAME OF

RICHARD D. HEVNER

Surveyed OCT. 13 1977, by J. S. DONALDSON
AUG. 29 1981 L.M. TOLL