


# T.7S. R.2W., W.M.

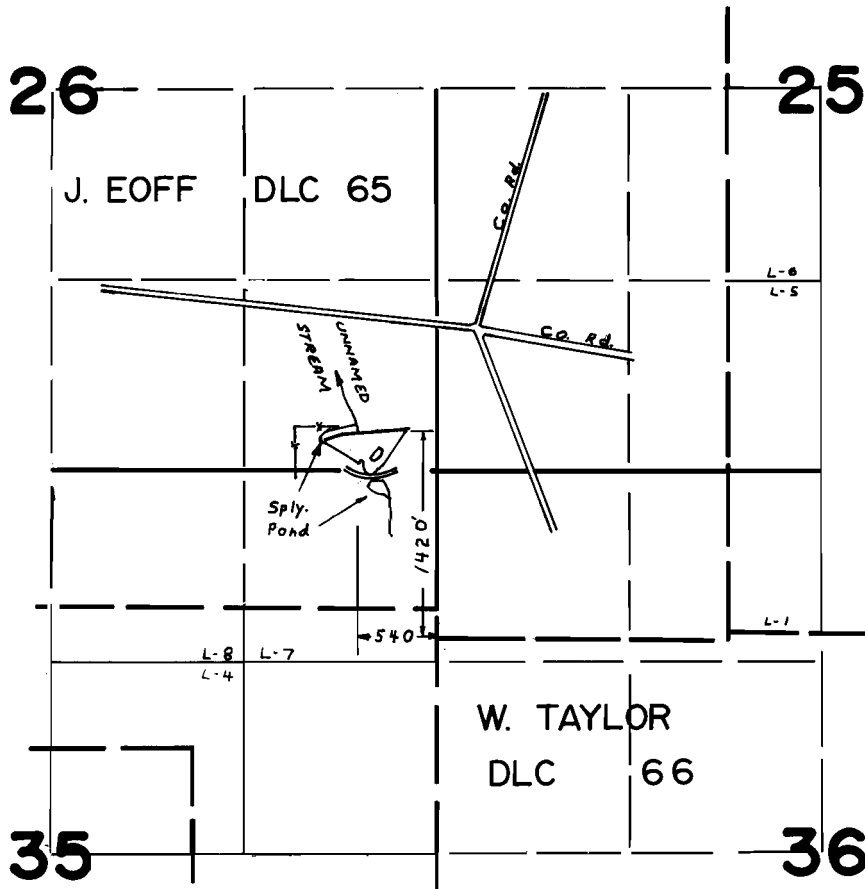

## FINAL PROOF SURVEY UNDER

R-48408 R-5653  
 Application No. 48409 Permit No. 35255...  
 IN NAME OF

.....DONALD J. PALUSKA.....

Surveyed AUG. 2, 1977, by B.R. SUND.....