


T.7S. R.2W., W.M.

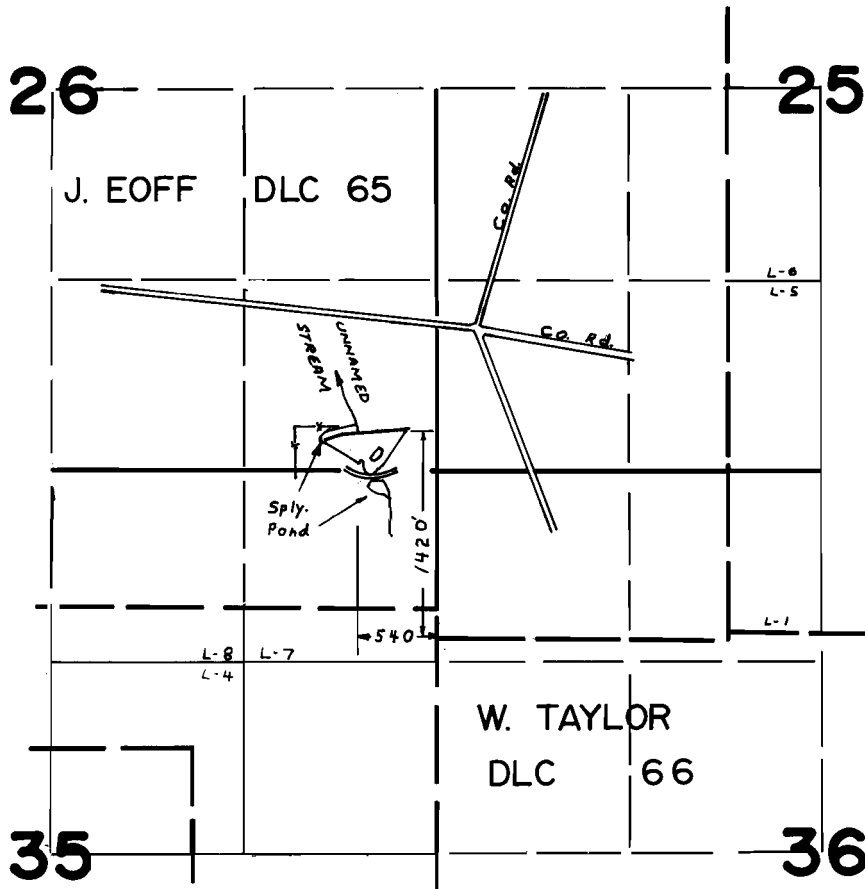

FINAL PROOF SURVEY UNDER

R-48408 R-5653
Application No. 48409 Permit No. 35255...
IN NAME OF

.....DONALD J. PALUSKA.....

Surveyed AUG. 2... 1977., by B.R. SUND.....