


T.9S.,R.5W.,W.M.

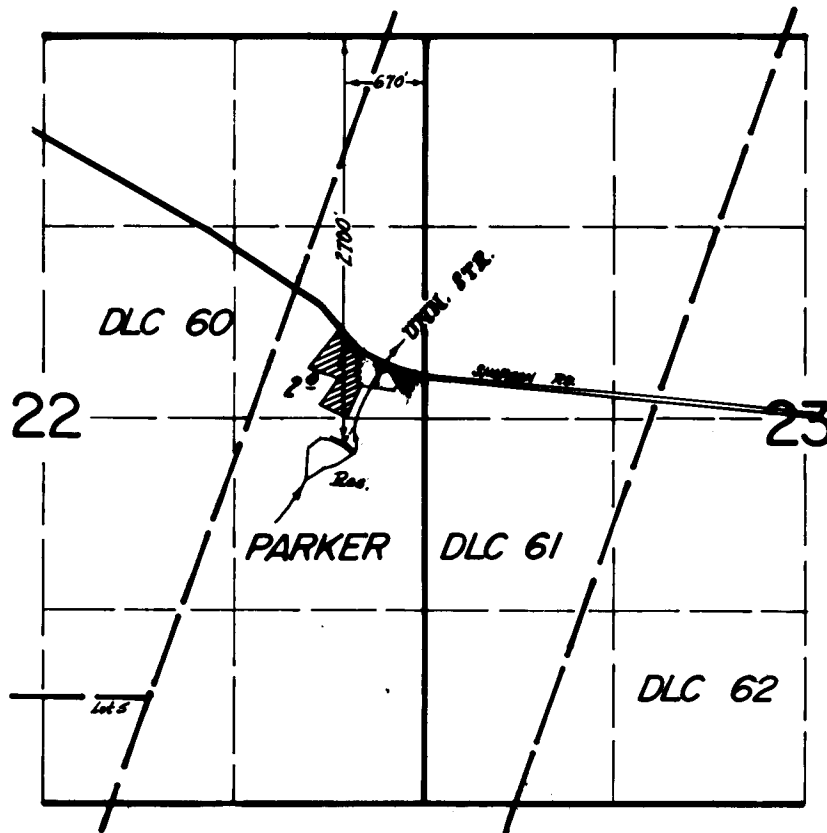

FINAL PROOF SURVEY
UNDER

R-46354 R-5517
Application No. 46355 Permit No. 34628
IN NAME OF

STEPHEN BENEDICT

Surveyed Oct. 11, 1978, by *A. P. Applegate*