


T.6S. R.3W., W.M.

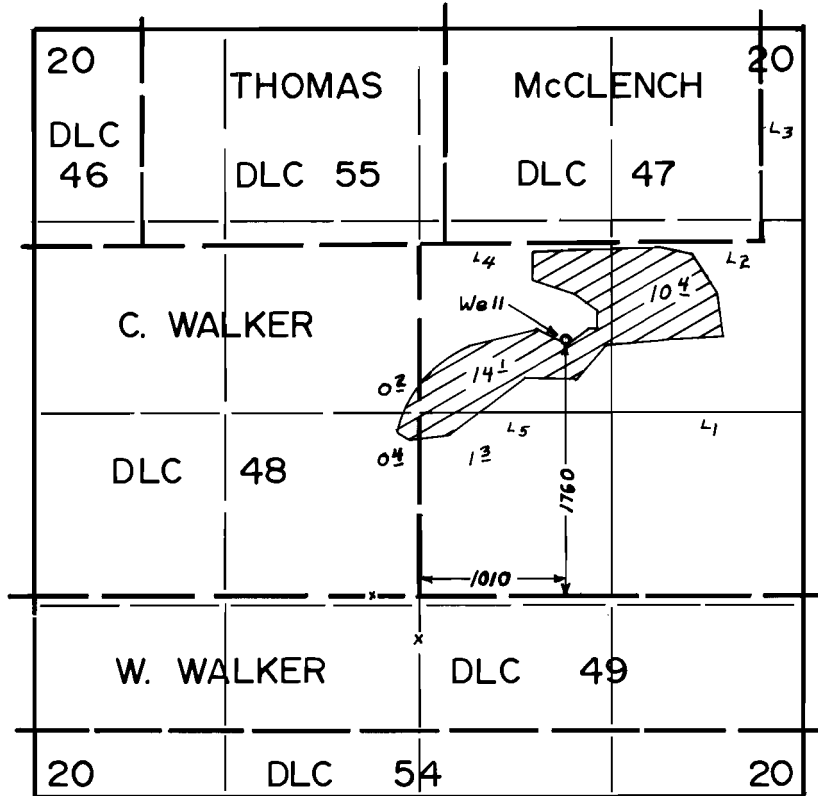

FINAL PROOF SURVEY UNDER

Application No. G-7666... Permit No. G-7103...
IN NAME OF

HENRY M. CHERRY

Surveyed MAR. 13. 1978., by J. S. DONALDSON