

RECEIVED

NOV 18 1981


WATER RESOURCES DEPT
SALEM, OREGON


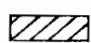
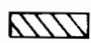
T. 38 & 4S. R. 14E. W.M.

RECEIVED

APR 2 1982

WATER RESOURCES DEPT
SALEM, OREGON

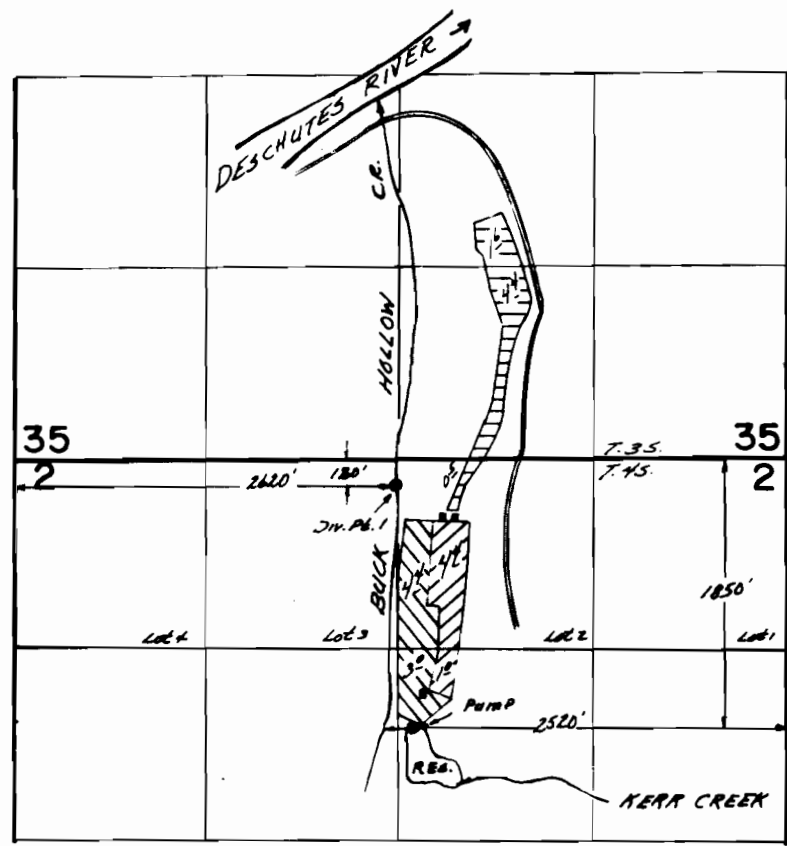

-  - Primary from Buck Hollow Creek
-  - Primary from Kerr Creek & Reservoir
-  - Suppl. from Kerr Creek & Reservoir

FINAL PROOF SURVEY
UNDER

R-49118 R-6150
Application No. 49119... Permit No. 38057.....
IN NAME OF

AGNES WEBB

Surveyed Sept. 12, 1979, by G.R. RODRIGUEZ.