


T3N R9W WM

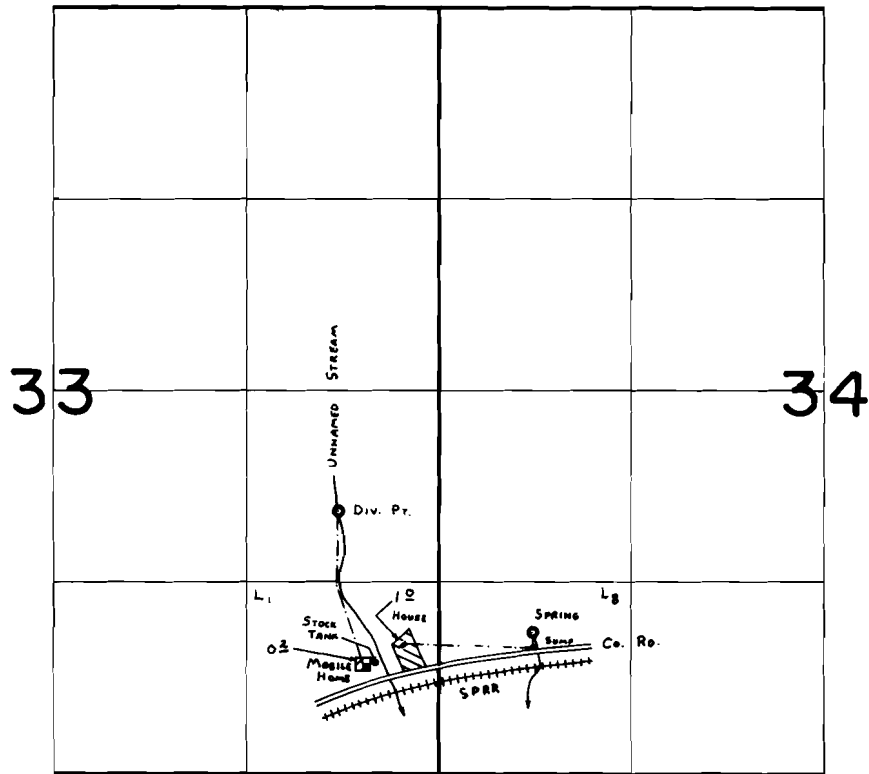

SPRING LOC: 350'S ± 640'E fr. N.W. Cor. Lot 8 (SW¹/₄ SW¹/₄), Sec 34
 STREAM DIV. PT. LOC: 490'N. ± 680'W. fr. N.E. Cor. Lot 1 (SE¹/₄ SE¹/₄), Sec 33

FINAL PROOF SURVEY UNDER

Application No. 57165 42914
 57166 Permit No. 42915.....
 IN NAME OF

.....JOHN J. GRIMES.....

Surveyed ..SEPT..19... 19..78., byC. L. HUGHES.....